


T.4S. R. 2 W.W.M.

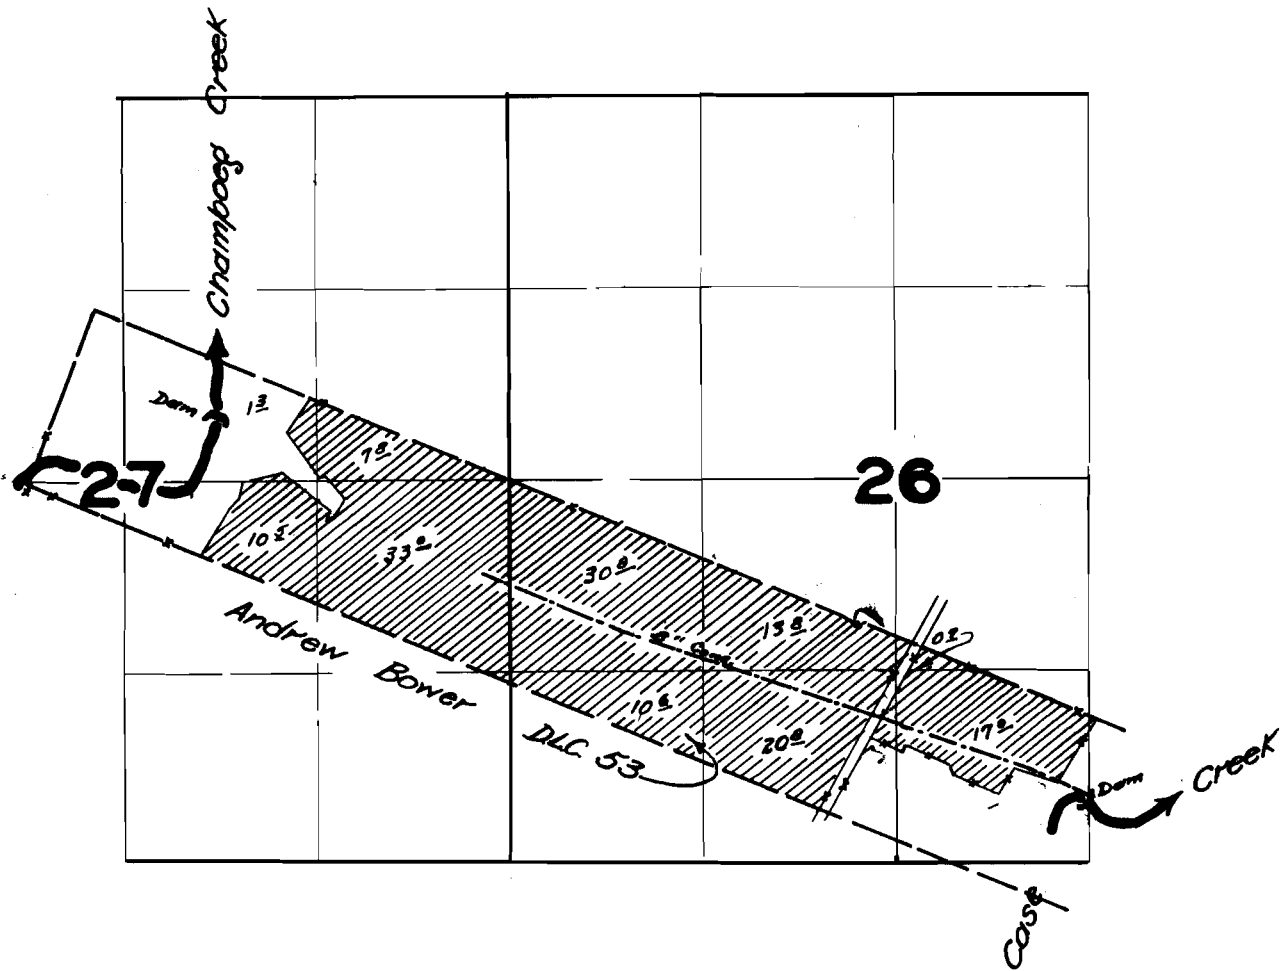

FINAL PROOF SURVEY UNDER

Application No. 17978 Permit No. 11000
IN NAME OF

NEAL W. MILLER

Surveyed 9 / 18 1952, by H. L. COFFMAN