


T.39S.R.36E.W.M.

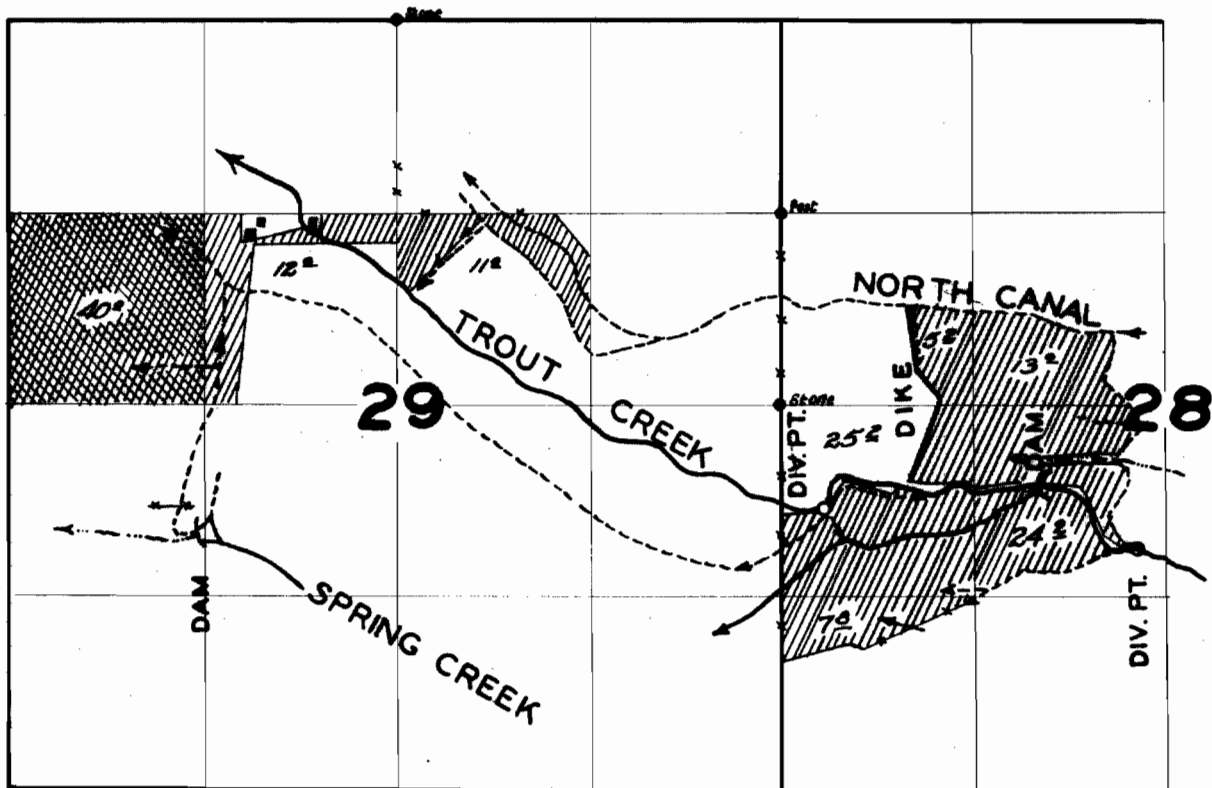

APPL. 18272

APPL. 17360

FINAL PROOF SURVEY

UNDER

17360

13067

Application No. 18272 Permit No. 13924

IN NAME OF

ALVIN M. OHMS

Surveyed 7/25 1951, by H. L. COFFMAN