


T.5S. R.6 W.W.M.

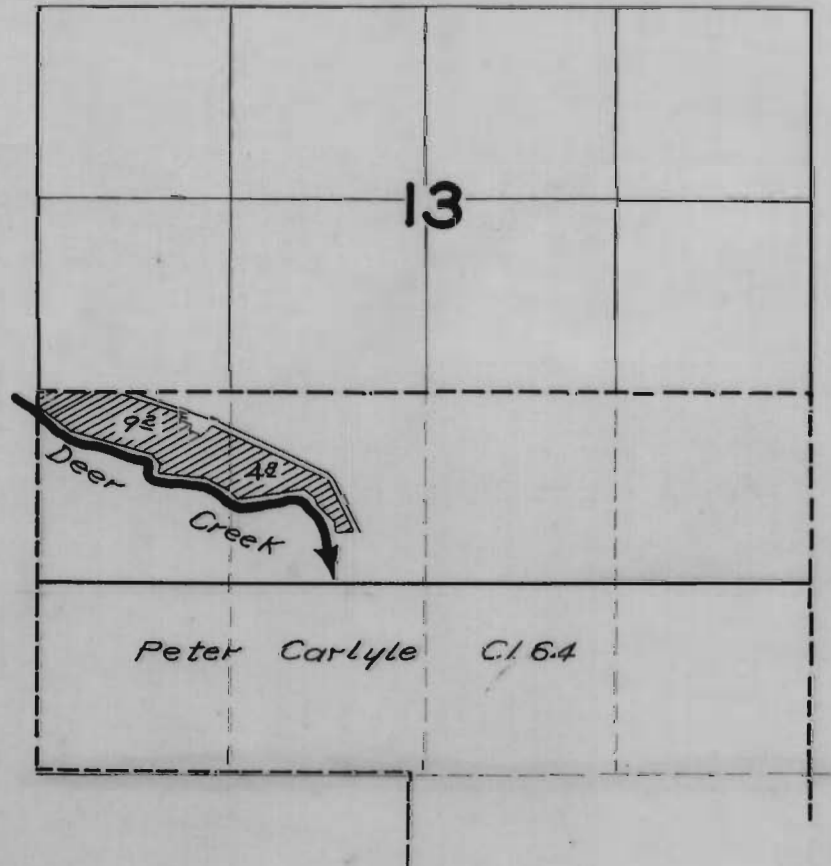

FINAL PROOF SURVEY

UNDER

Application No. 18795 Permit No. 14436
IN NAME OF

M. P. CARLUFF

Surveyed 9/24 1951, by H.L. COFFMAN