


# T.2N.R2&3W.W.M.

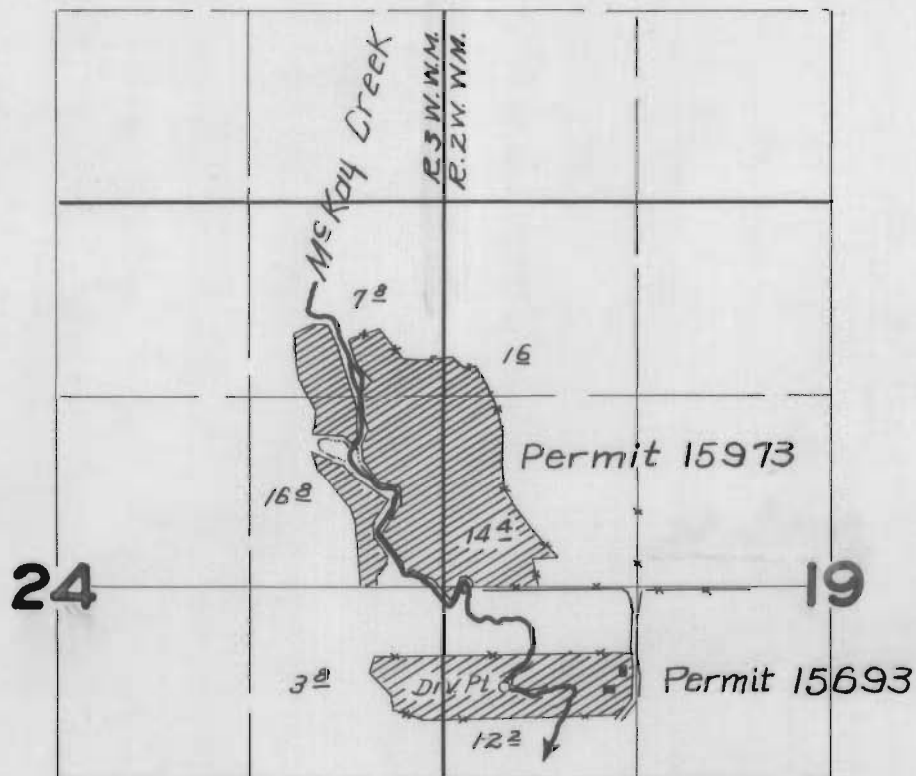

## FINAL PROOF SURVEY

UNDER

20456

15973

Application No. 20130 Permit No. 15693

IN NAME OF

F. R. Henning

J. LeRoy Mills

Surveyed 6 / 18 1952, by H. L. COFFMAN