


# T.I.S.R.2 W.W.M.

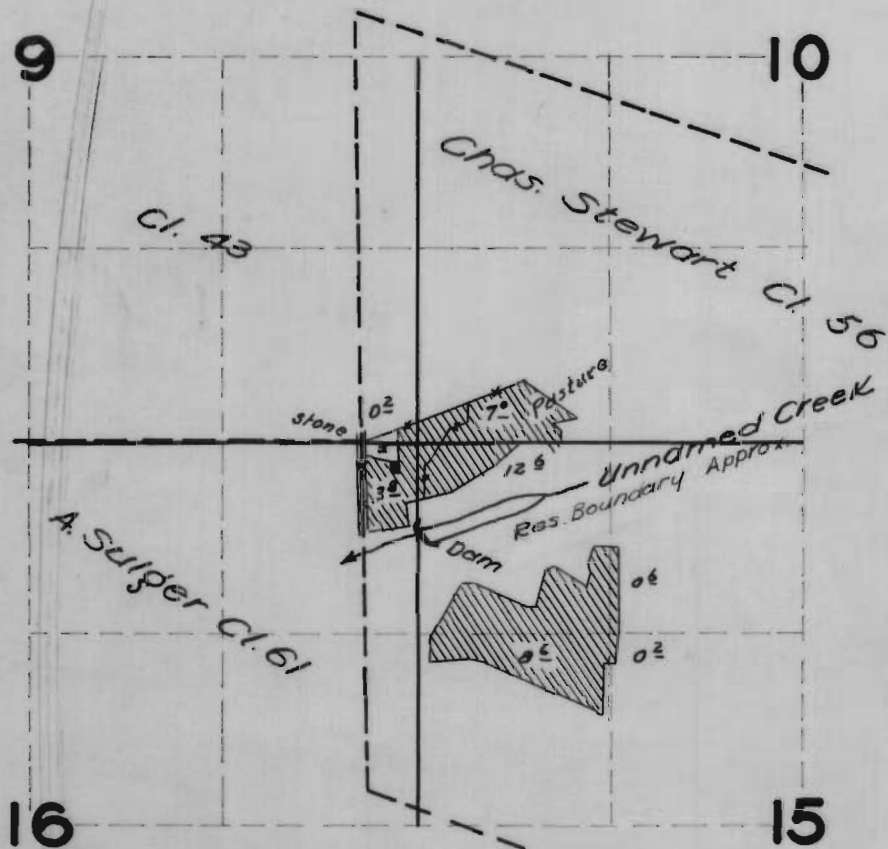

## FINAL PROOF SURVEY UNDER

Application No. 20795 Permit No. 18290  
IN NAME OF

WILSON A. & CORRINE V. ETTINGER

Surveyed May 13, 1952, by H. L. COFFMAN