


T.3S.R.40E.W.M.

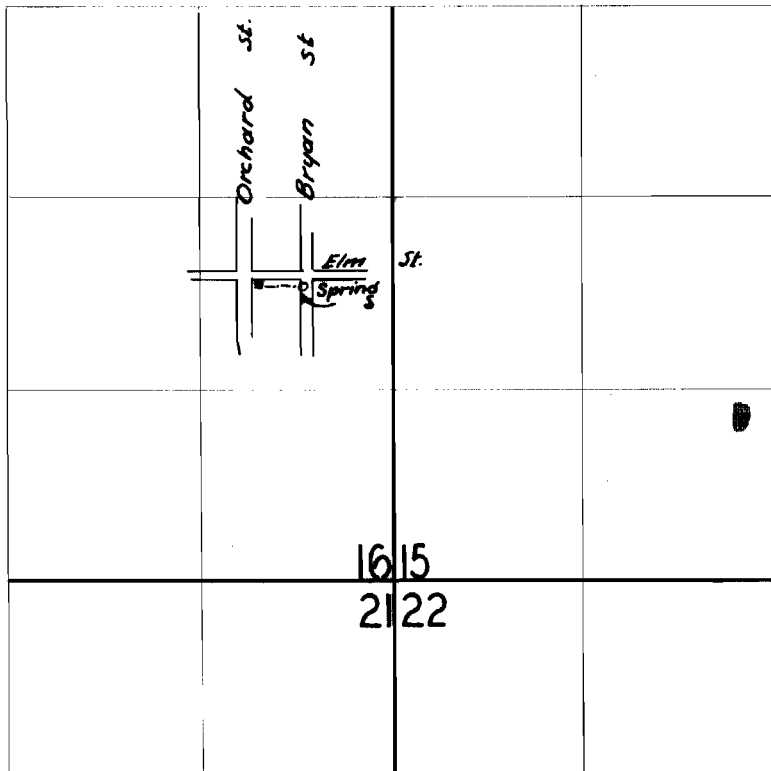

FINAL PROOF SURVEY

UNDER

Application No. 21203 Permit No. 16620
IN NAME OF

J.O. & H.L. MILLER

Surveyed 10/26 1951, by H.L. COFFMAN