


T. IS. R. 4 W. W. M.

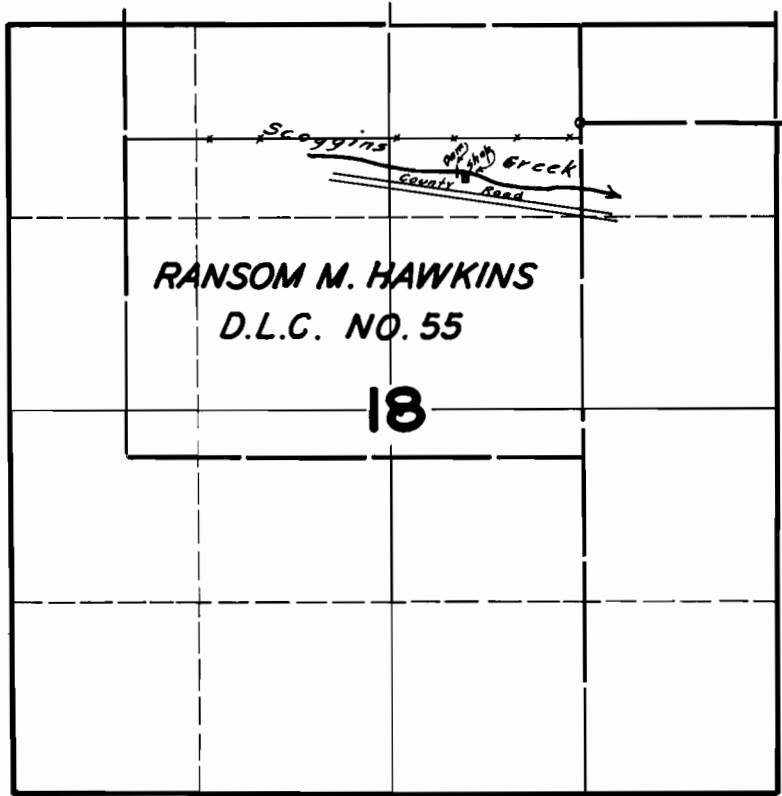

**FINAL PROOF SURVEY
UNDER**

Application No. 21318 Permit No. 16717

IN NAME OF

S. ROY MATTESON

Surveyed AUG. 16, 1946, by