


Application No. 5830

Permit No. 3582

(Mc) R. Spum-Jackson & J. J. J. Anderson
Ditch, on the part thereof used in their appropriation.

[4-590]

Township No. 14 North Range No. 33, E. 7th Mer.

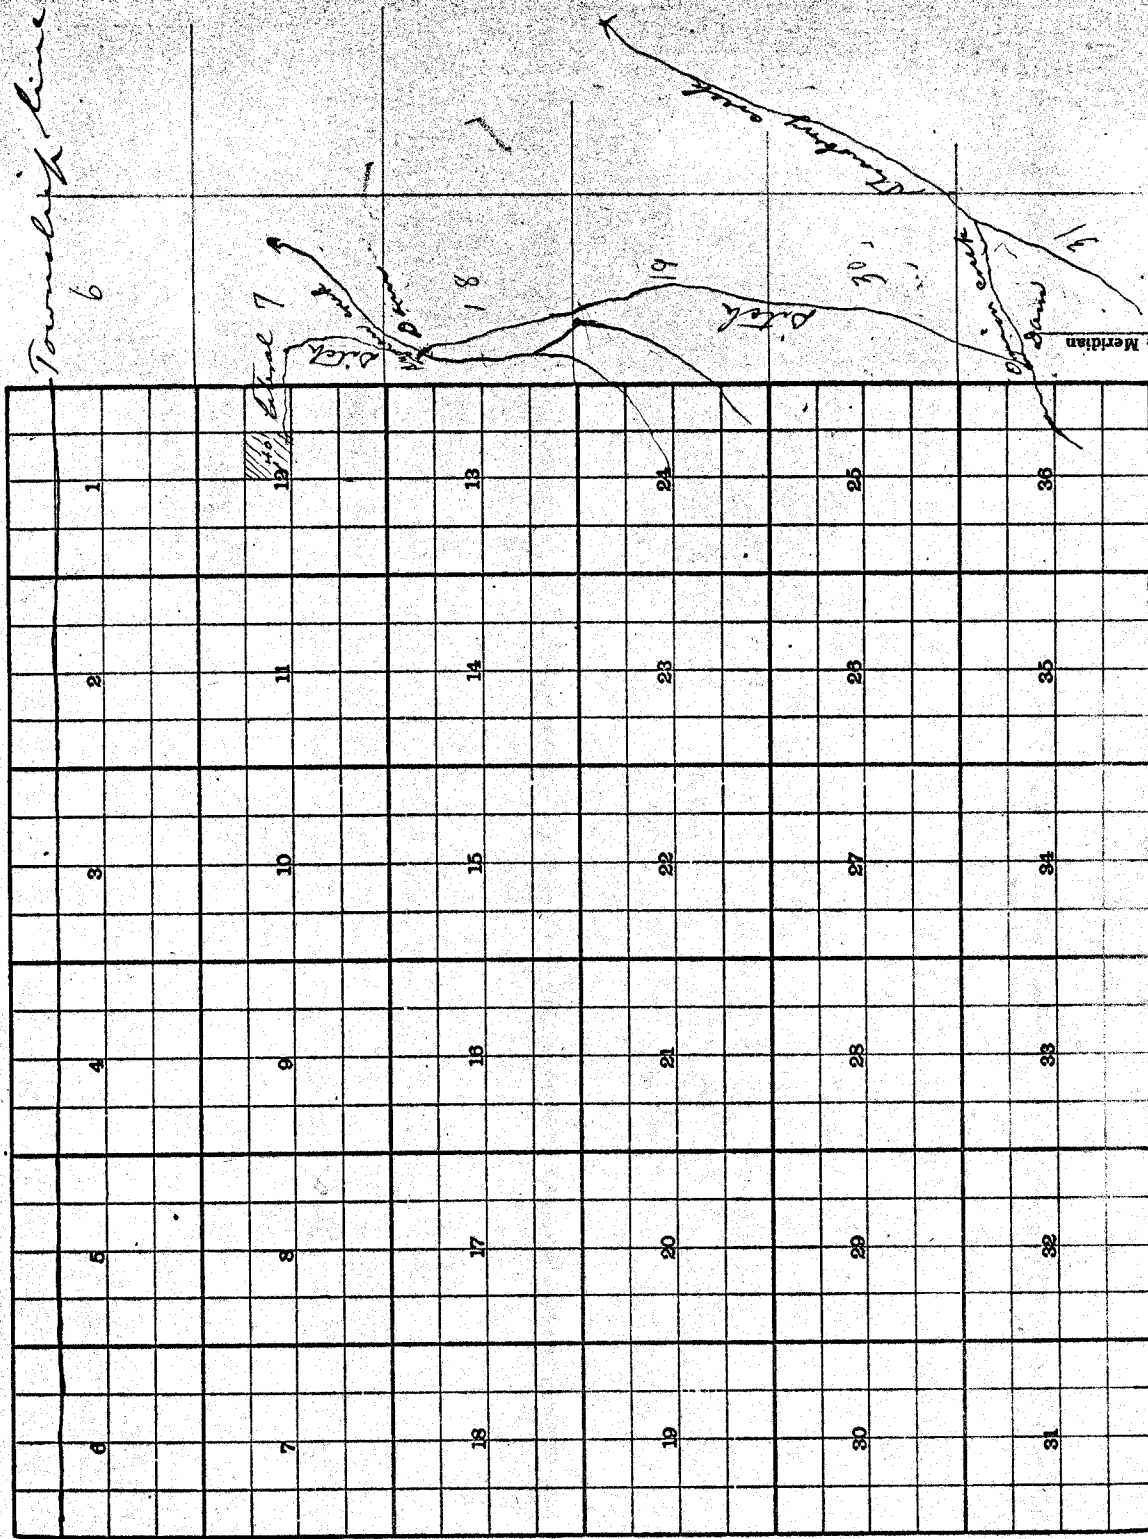

OFFICE OF STATE ENGINEER

RECEIVED

NOV 8 1917

SALEM, OREGON

Map drawn at the direction of
J. E. Eastman.

Per 3582
2001