


T. I. S. R. 4 W. W. M.

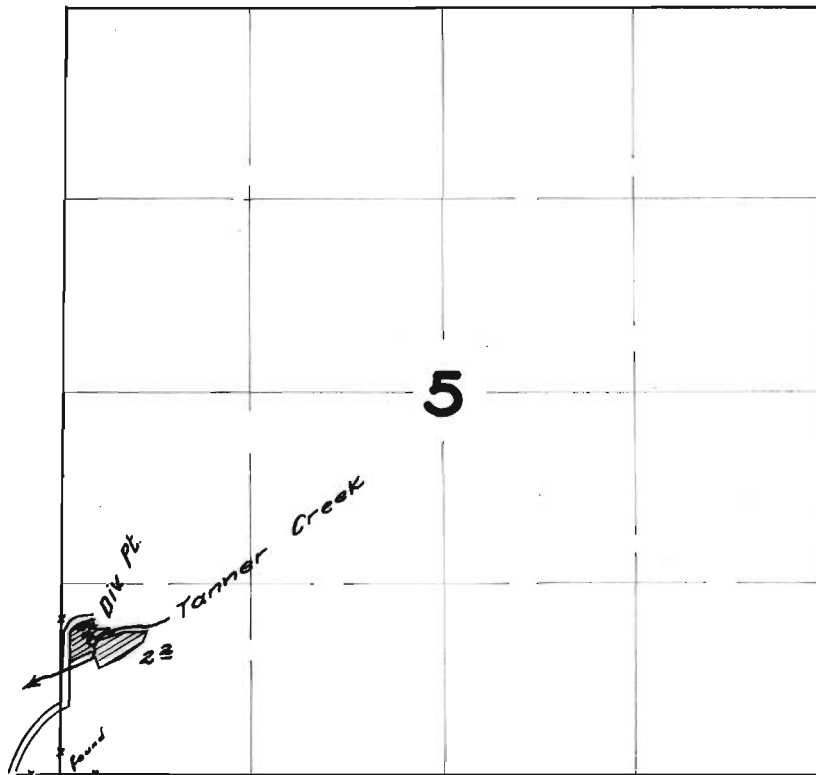

FINAL PROOF SURVEY

UNDER

Application No. 21109 Permit No. 16783

IN NAME OF

ROLLO L. KINTZ

Surveyed Apr. 11, 1952, by H. L. GOFFMAN