


T.4S.R.5W.W.M.

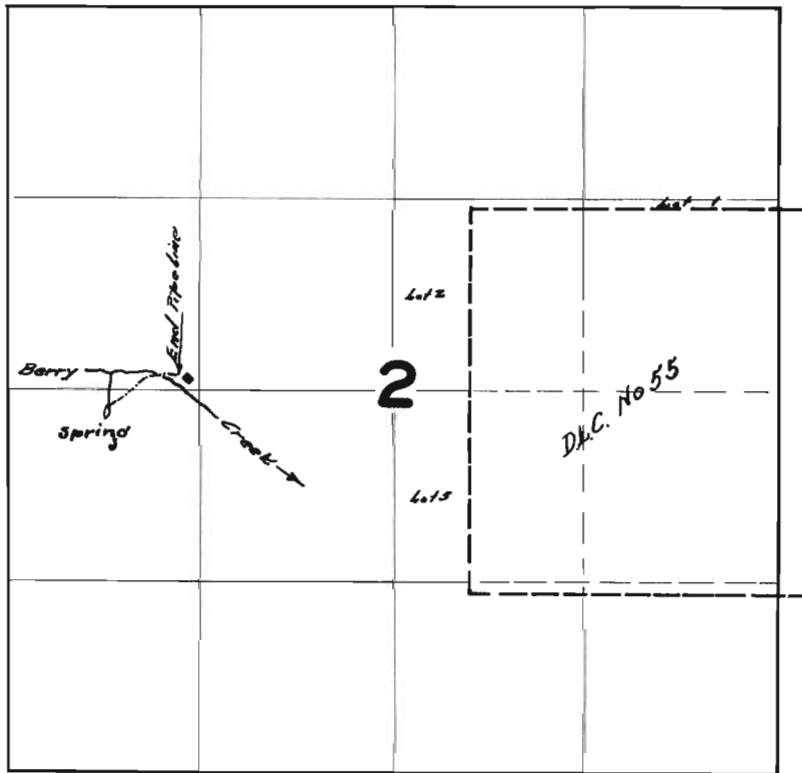

FINAL PROOF SURVEY

UNDER

Application No. 21400. Permit No. 16800
IN NAME OF

ANDREW C. PETERSON

Surveyed 10/4 1951, by H.L. COFFMAN