


T.I.S.R.3W.W.M.

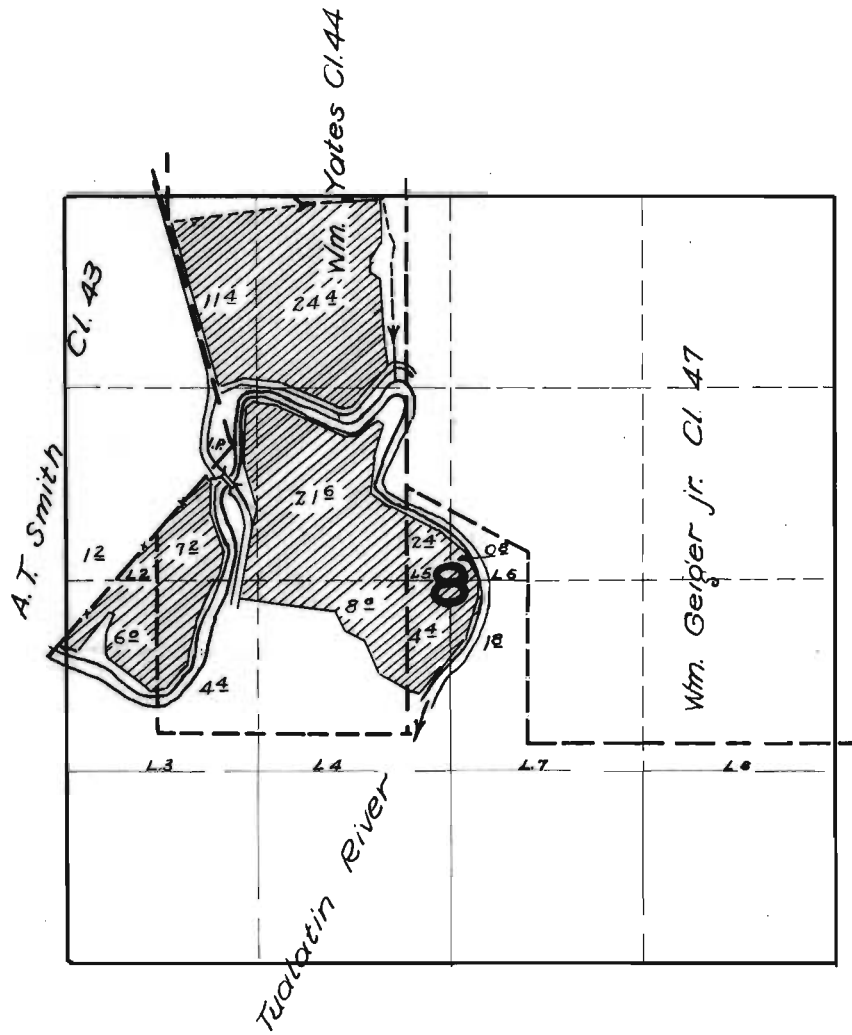

FINAL PROOF SURVEY

UNDER

Application No. 21153 Permit No. 16830

IN NAME OF

J. W. NELSON

Surveyed May 23, 1952, by H. L. COFFMAN