


T.15S.R.12W.W.M.

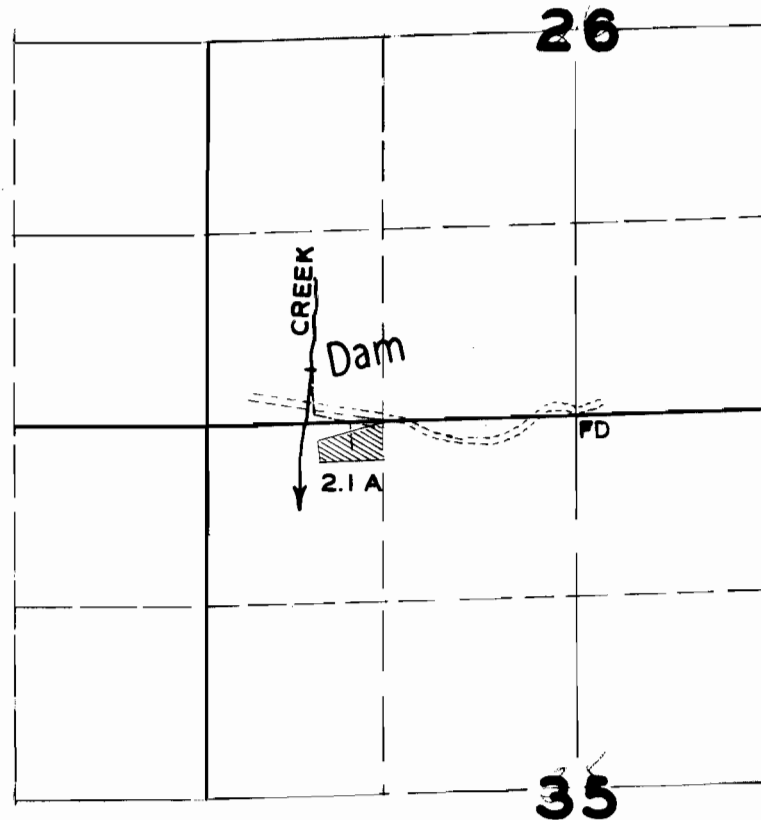

FINAL PROOF SURVEY

UNDER

Application No. **21571**... Permit No. **16950**.
IN NAME OF

JOSEPH T. BRAY

Surveyed **JUNE 8, 1950**, by **H.L. COFFMAN**.