


T.5S.R.1W.W.M.

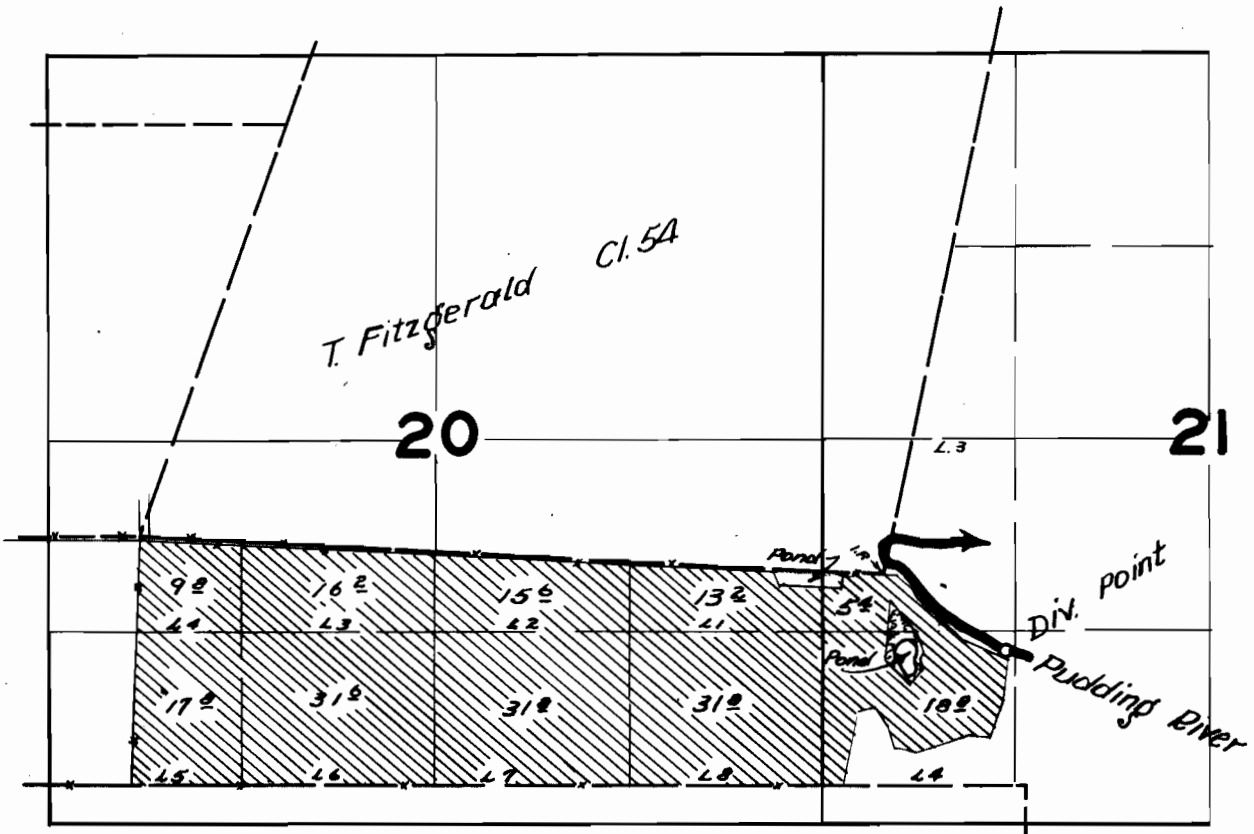

FINAL PROOF SURVEY

UNDER

Application No. 21664 Permit No. 17011

IN NAME OF

FRED GESCHWILL

Surveyed 9 / 17 1952, by H. L. COFFMAN