


T.9S.R.4E.W.W.M.

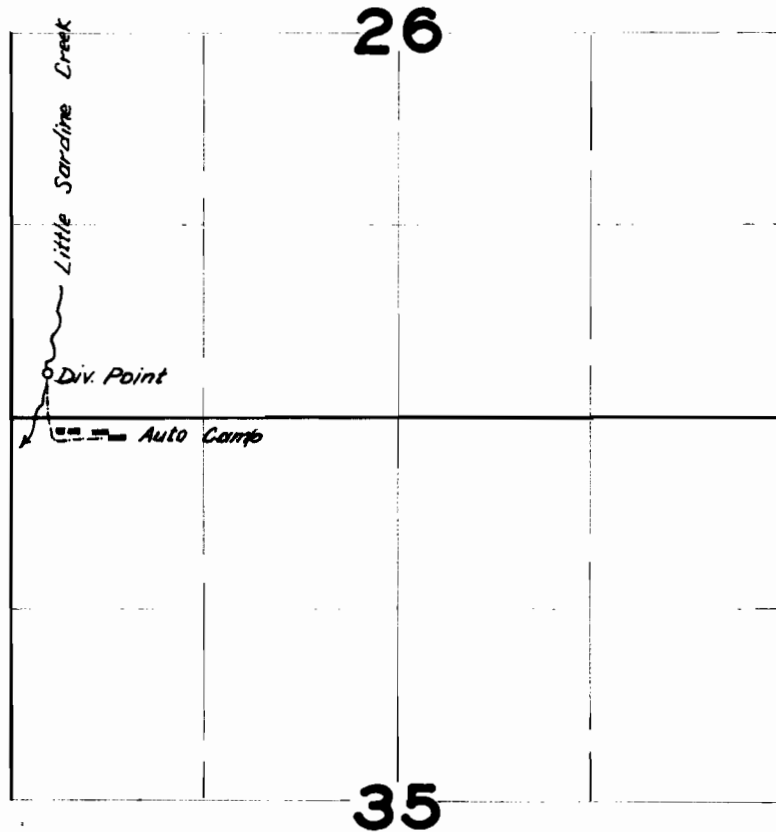

FINAL PROOF SURVEY UNDER

Application No. 22242 Permit No. 17545
IN NAME OF

J. D. BURROUGHS

Surveyed 9 / 24 1952, by H. L. COFFMAN