


SECTION

TOWNSHIP / *N* , RANGE / *W* , W. M.

North

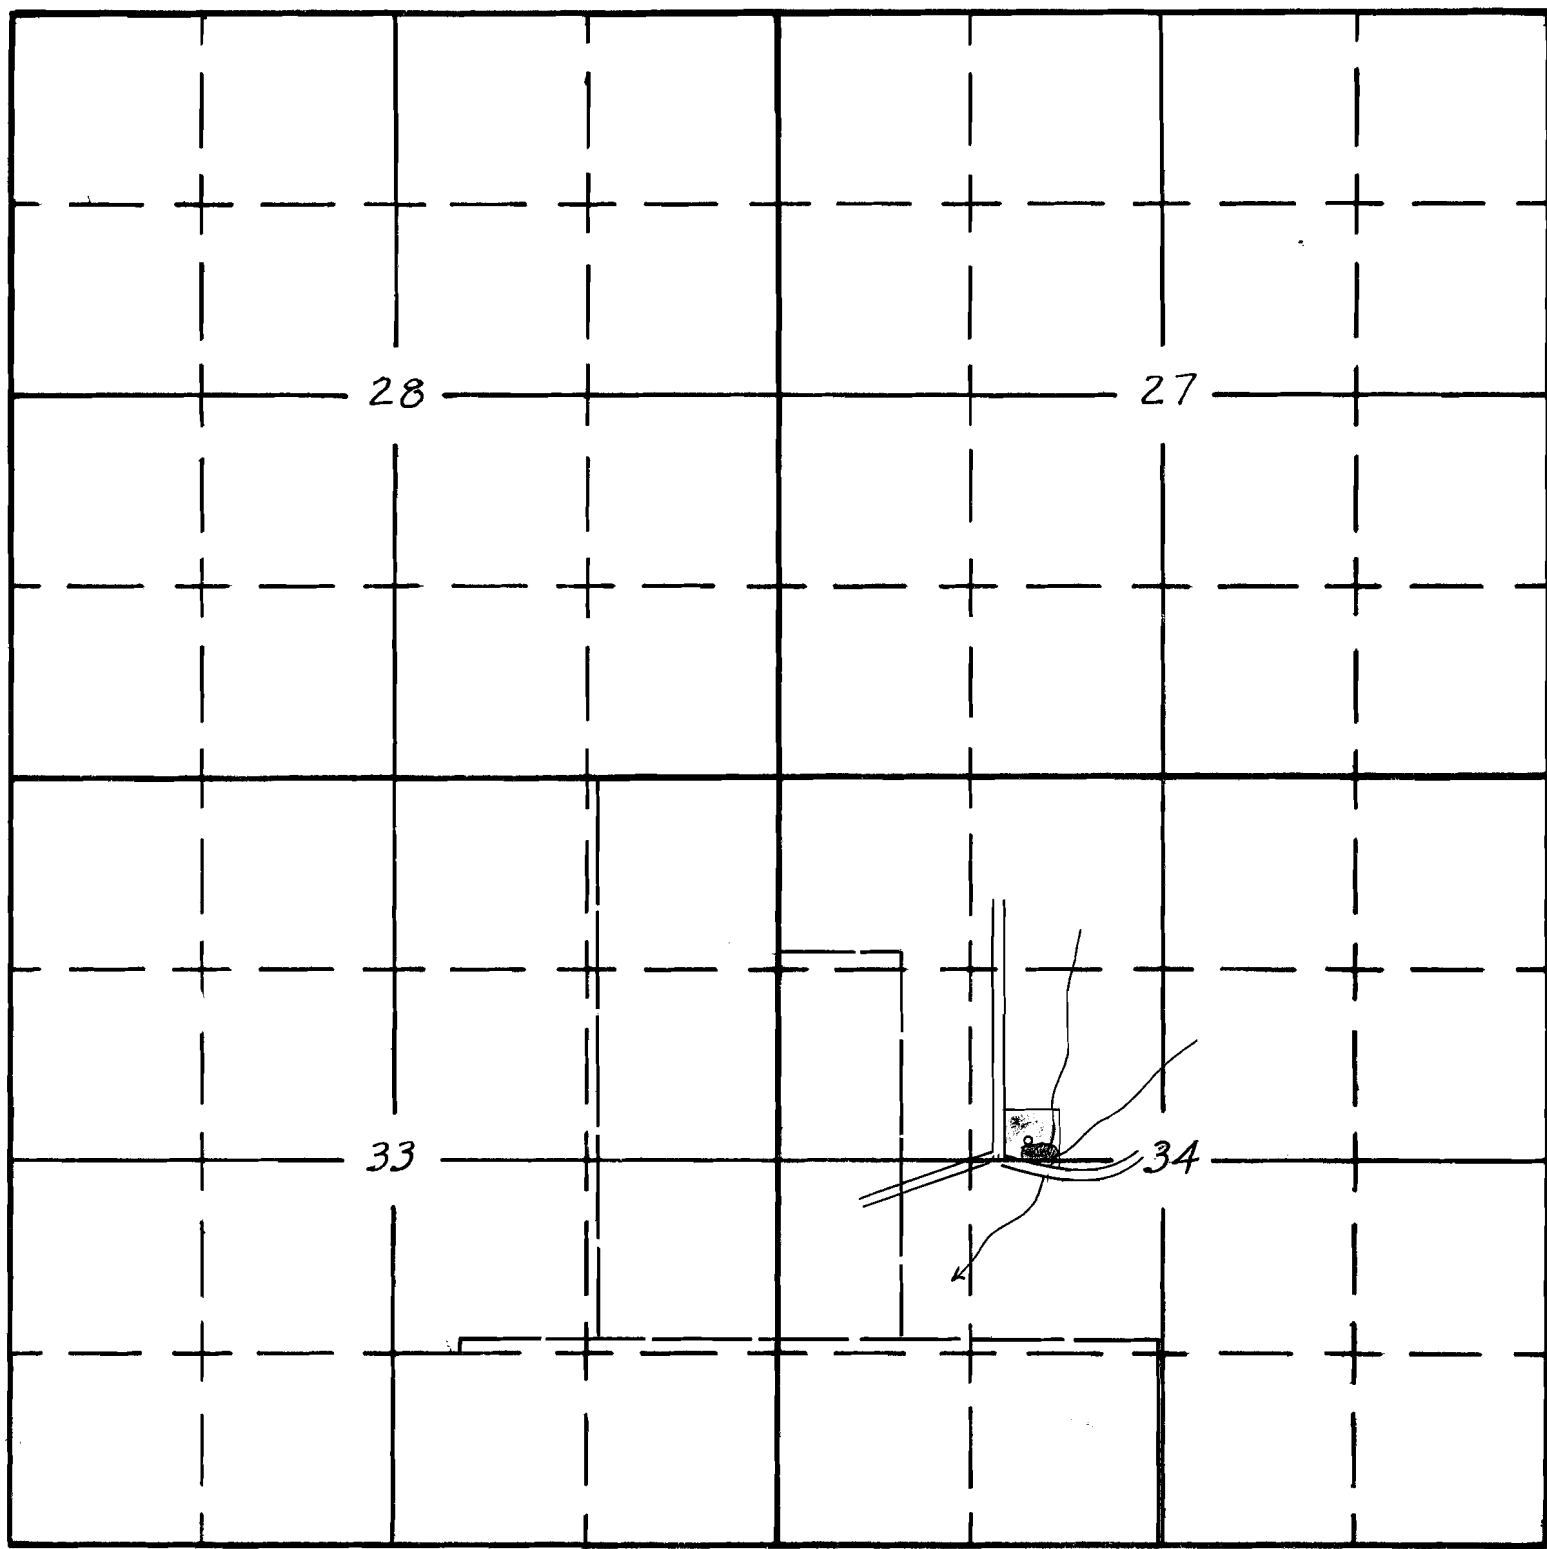

West


East

South

APPLICATION No. *R-22097*
 22098
 PERMIT No. _____

11/1/00

T.I.N.R.I.W.W.M.

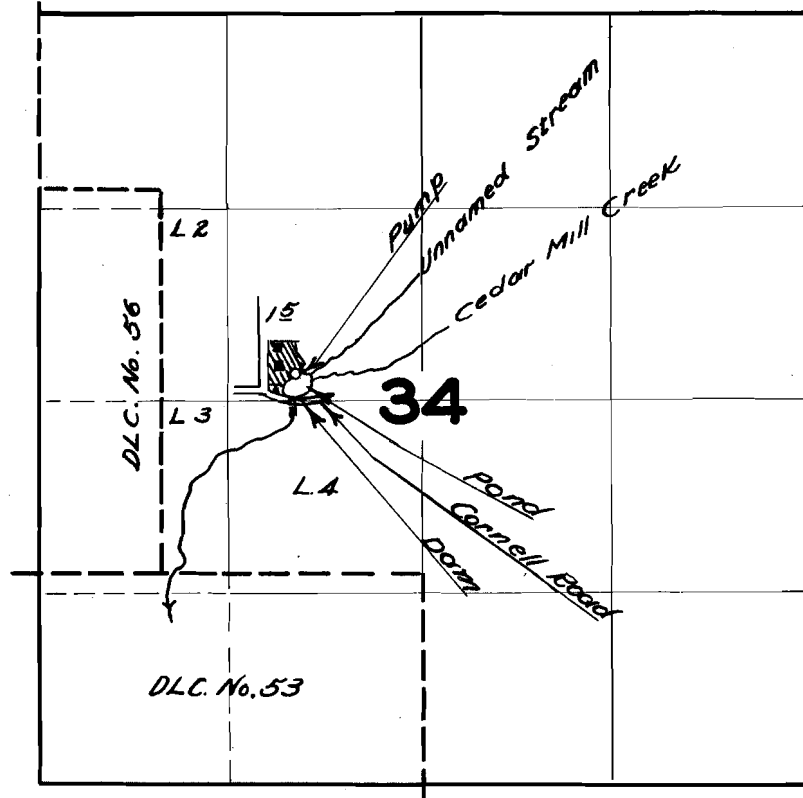

FINAL PROOF SURVEY UNDER

Application No. 22098. Permit No. 175.28.
IN NAME OF

DARREL F. PETERSON

Surveyed 6/27, 1951, by H.L. COFFMAN