


T.16S.R.3E.W.M.

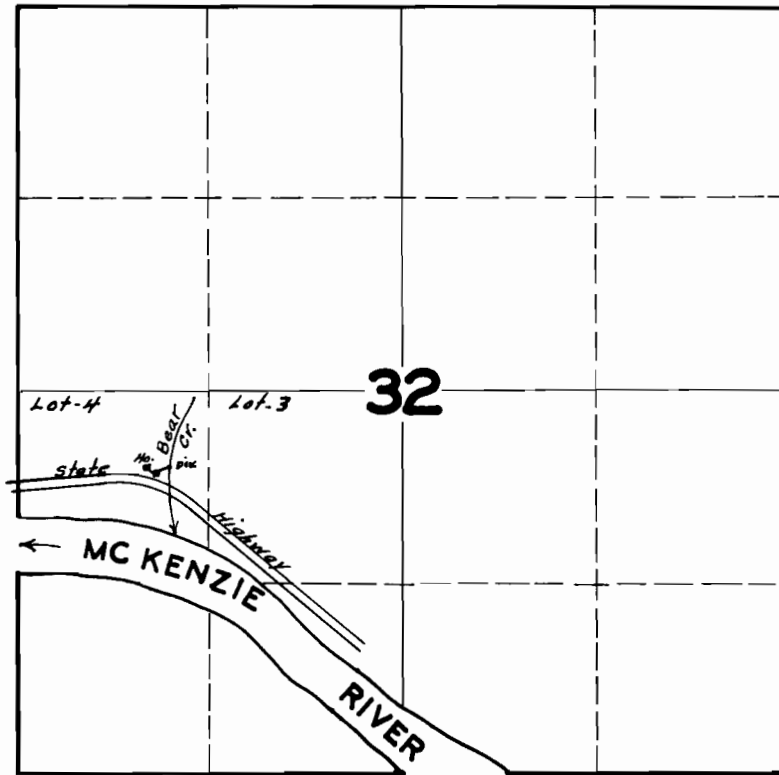

**FINAL PROOF SURVEY**  
UNDER

Application No. 19185 Permit No. 14782

IN NAME OF  
WALTER M. RANSOM

Surveyed JULY 31 1946 by James C. Russell