


T.14 S. R. 2W.WM.

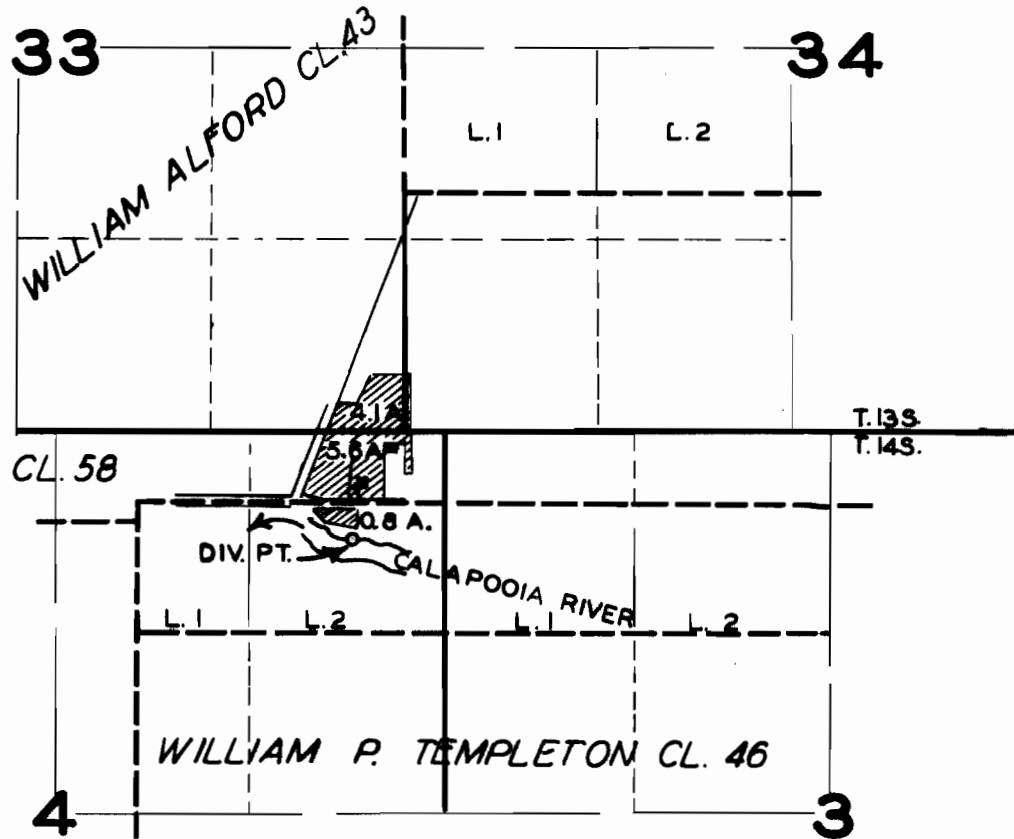

FINAL PROOF SURVEY

UNDER

Application No. 22196... Permit No. 17479..

IN NAME OF

C. M. MISHLER

Surveyed APR. 25, 1951., by H.L. COFFMAN.