


T. 1 S. R. 4 W. W. M.

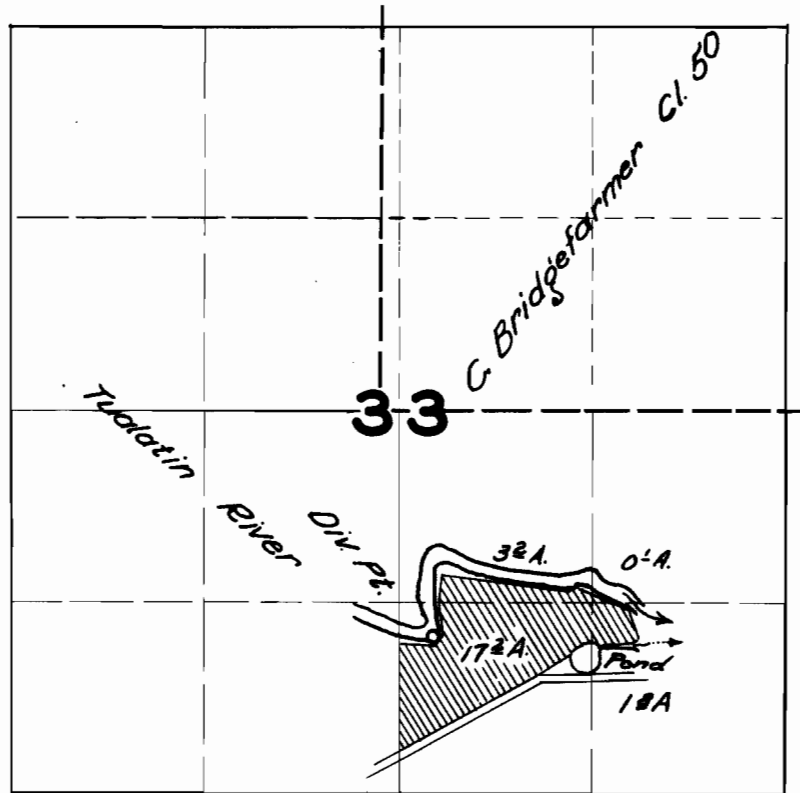

FINAL PROOF SURVEY UNDER

Application No. **22239** Permit No. **17504**
IN NAME OF

C. W. SUHRBIER

Surveyed APR. 2, 1952, by H. L. COFFMAN