


T. 1 N. R. 4 W. W. M.

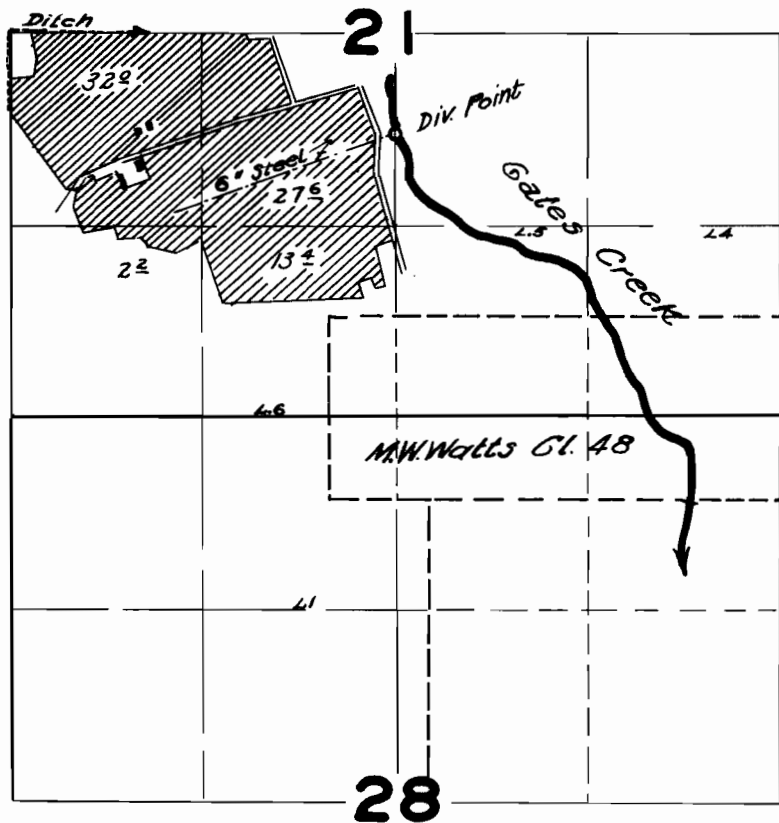

FINAL PROOF SURVEY UNDER

Application No. 22282 Permit No. 17384

IN NAME OF

WALTER PARKIN

Surveyed 7 / 17 1952, by H. L. COFFMAN