


T.I.S.R.4W.W.M.

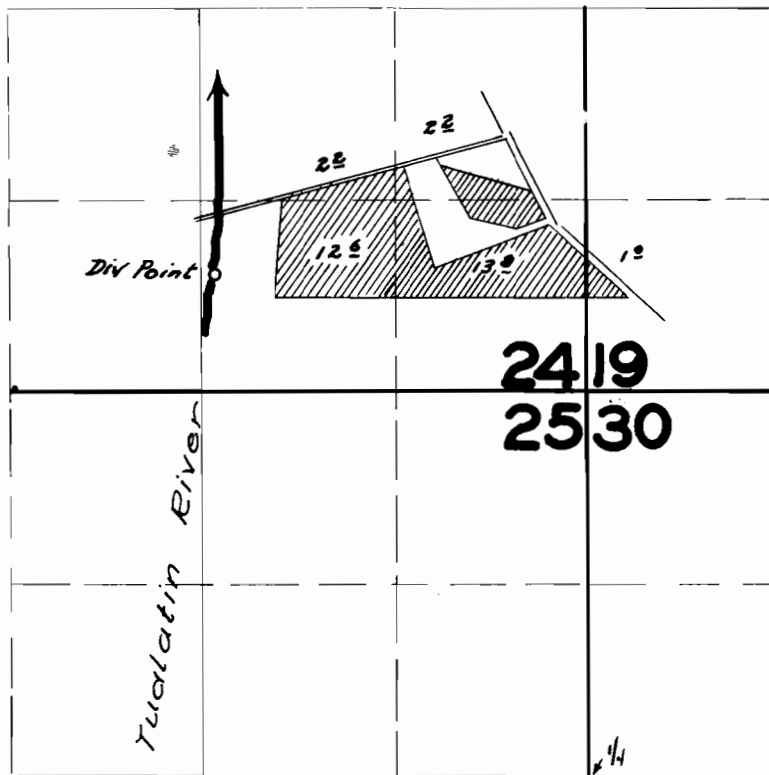

FINAL PROOF SURVEY

UNDER

Application No. 22283 Permit No. 17385

IN NAME OF

JOHN K. HINKEL

Surveyed 4 / 16 1952, by H. L. COFFMAN