


T.2S.R.38E.W.M.

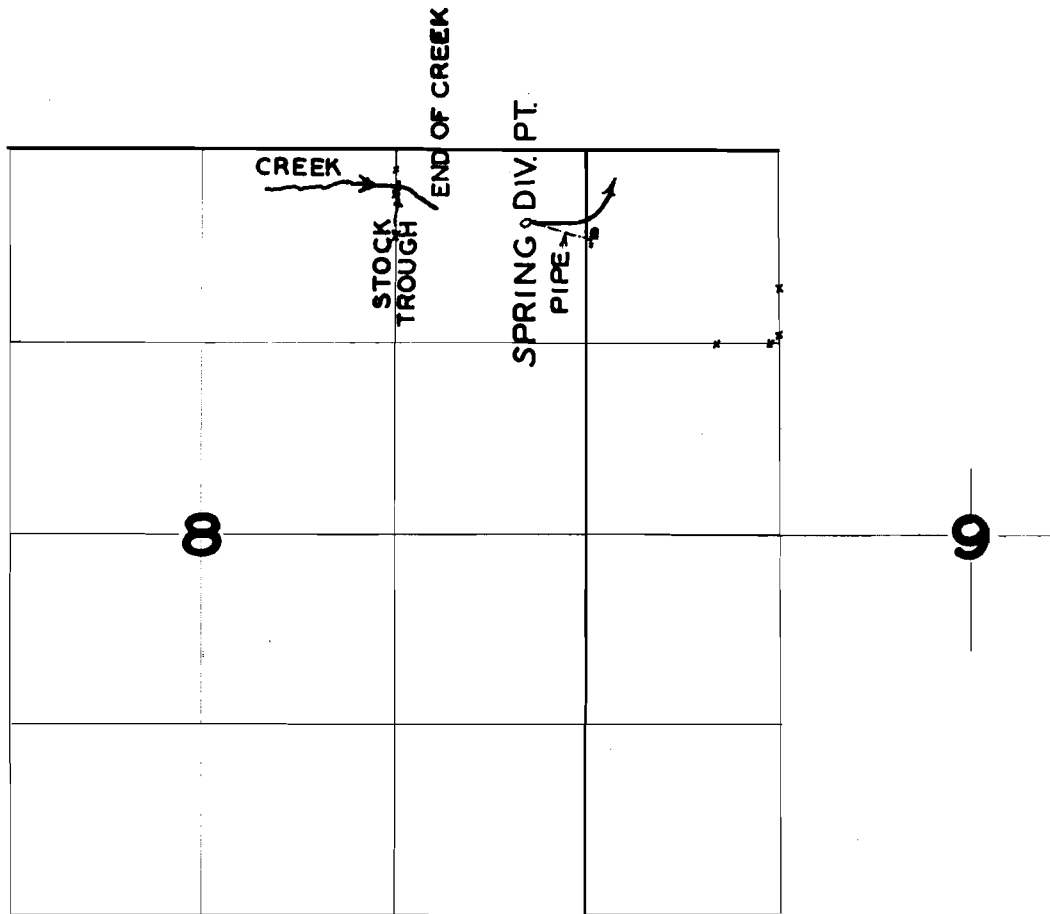

FINAL PROOF SURVEY

UNDER

Application No. 22348 Permit No. 17620

IN NAME OF

C.A. RILEY

Surveyed 10/25 1951, by H.L. COFFMAN