


T. 1 N. R. 4 W. W. M.

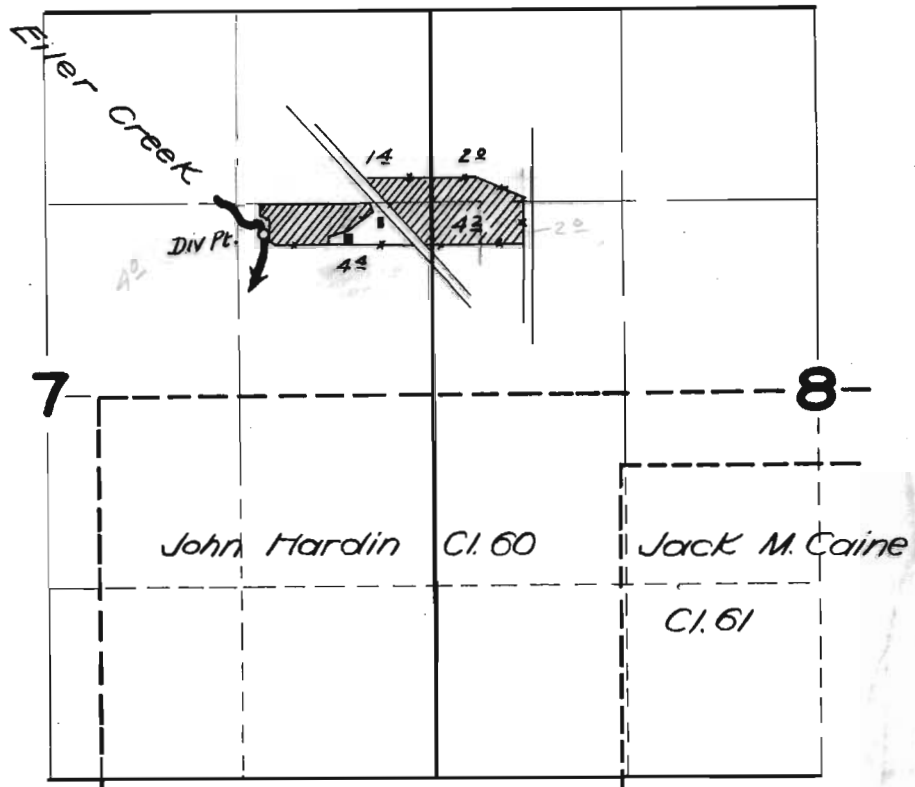

FINAL PROOF SURVEY

UNDER

Application No. 22344 Permit No. 17618

IN NAME OF

ARCHIE B. CURWICK

Surveyed May 22, 1952, by H. L. GOFFMAN