


T. I. S. R. I. W. W. M.

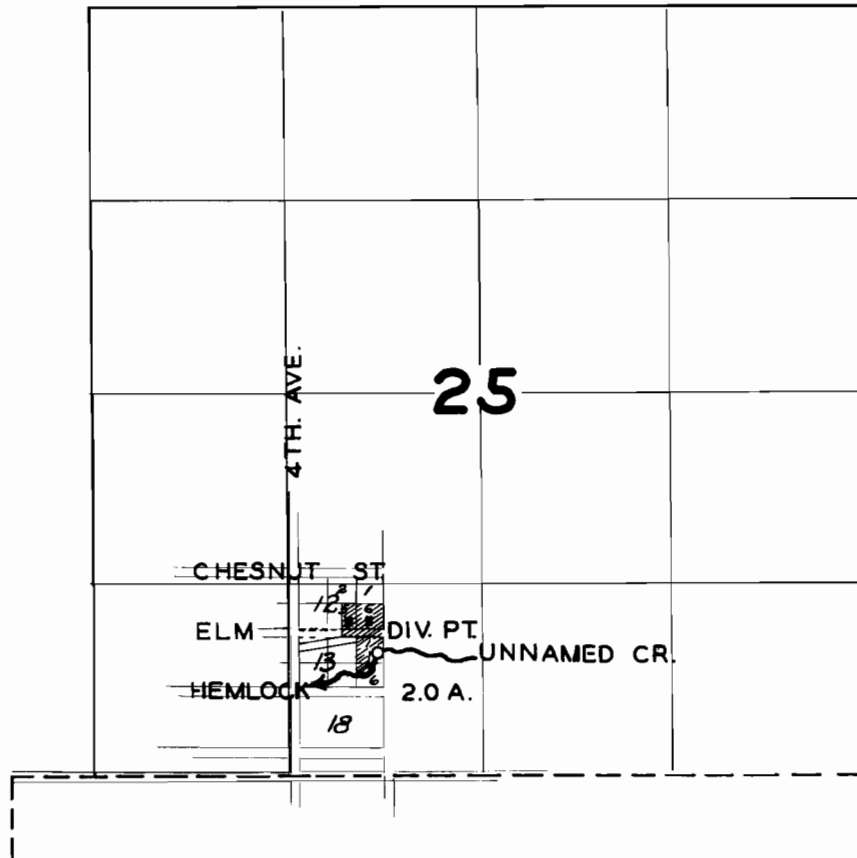

FINAL PROOF SURVEY

UNDER

Application No. 2 2363 Permit No. 17631

IN NAME OF

J. O. JOHNSON

Surveyed MAY 11 1951, by H. L. COFFMAN.