


# T.I.S.R. 2W.W.M.

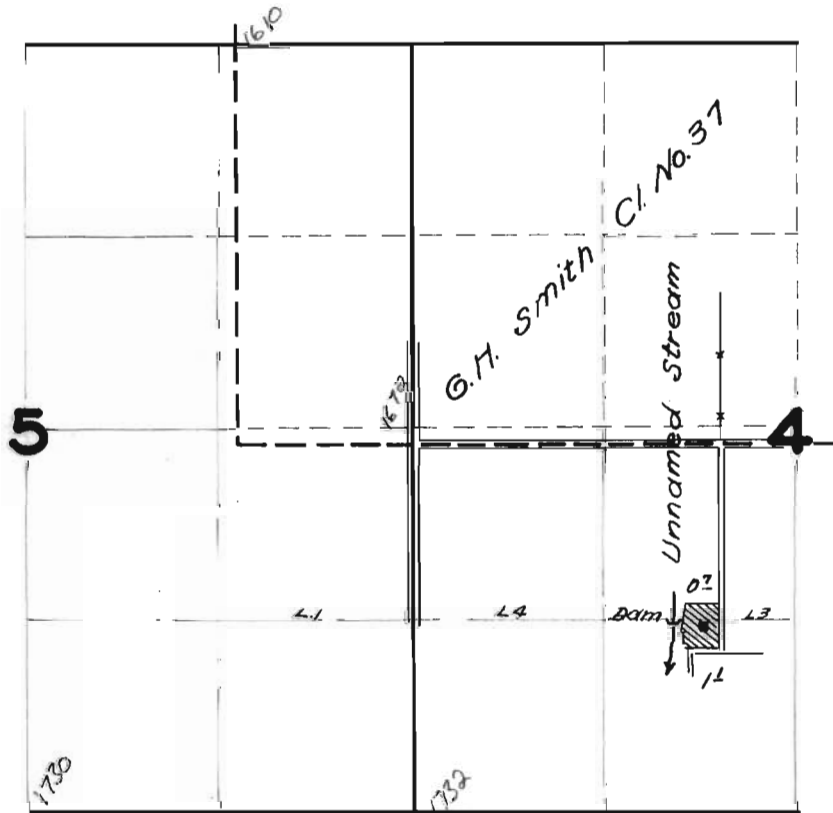

## FINAL PROOF SURVEY

UNDER

Application No. 22429 Permit No. 17674

IN NAME OF

SHERMAN SHERBECK

Surveyed 6 / 2 1952, by H. L. COFFMAN