


T. IN. R. 4 W. W. M.

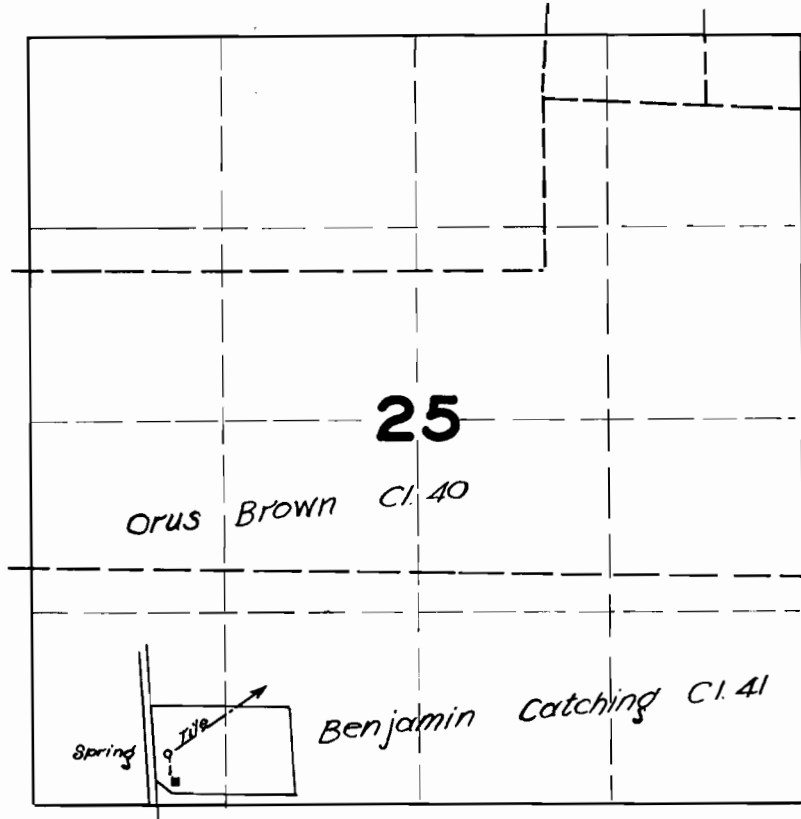

FINAL PROOF SURVEY

UNDER

Application No. 22791 Permit No. 18116

IN NAME OF

R. M. JONES

Surveyed 7 / 17. 1952, by H. L. COFFMAN