


T.10S. R.3W.W.M.

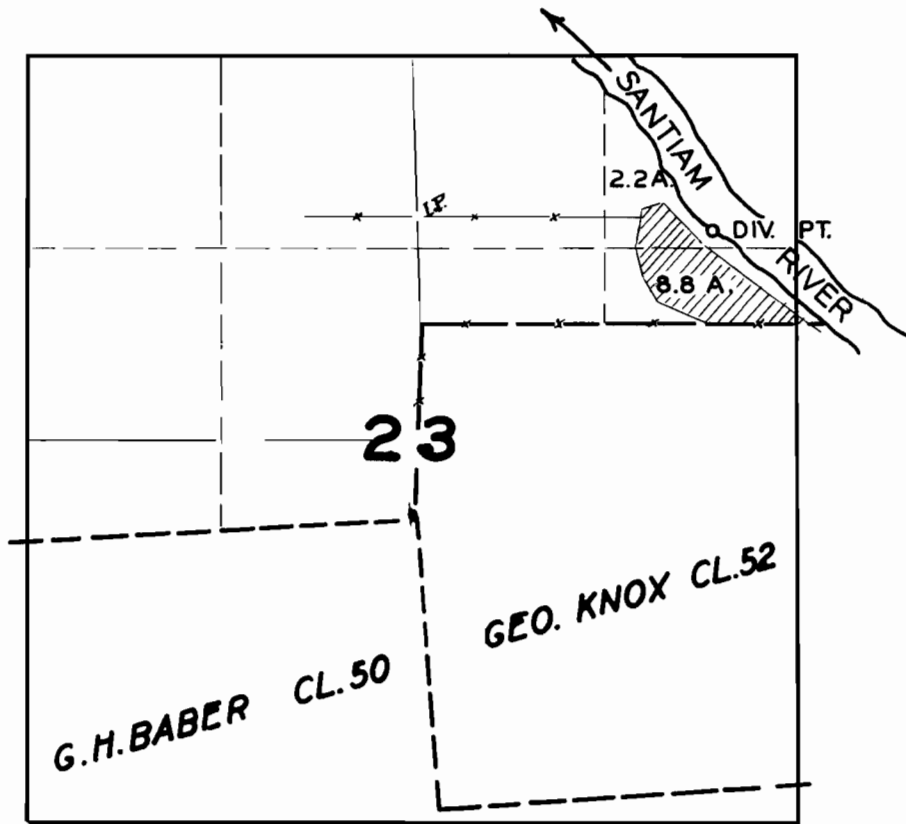

FINAL PROOF SURVEY
UNDER

Application No. 22511... Permit No. 18017...
IN NAME OF

LESTER H. LARSON

Surveyed APR. 12, 1951, by H.L. COFFMAN