


T.1N.R. 2 W.W.M.

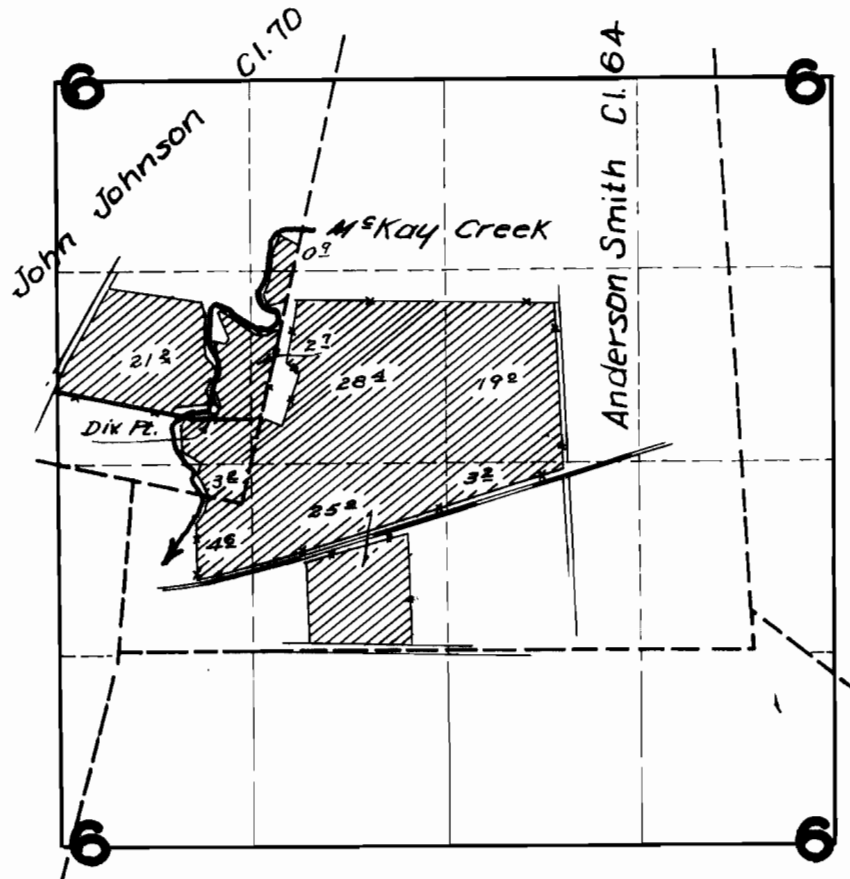

FINAL PROOF SURVEY

UNDER

Application No. 23154 Permit No. 18241

IN NAME OF

EDWARD SPIERING

Surveyed 6 / 16 1952, by H. L. COFFMAN