


T.I.S. R. 4 W.W.M.

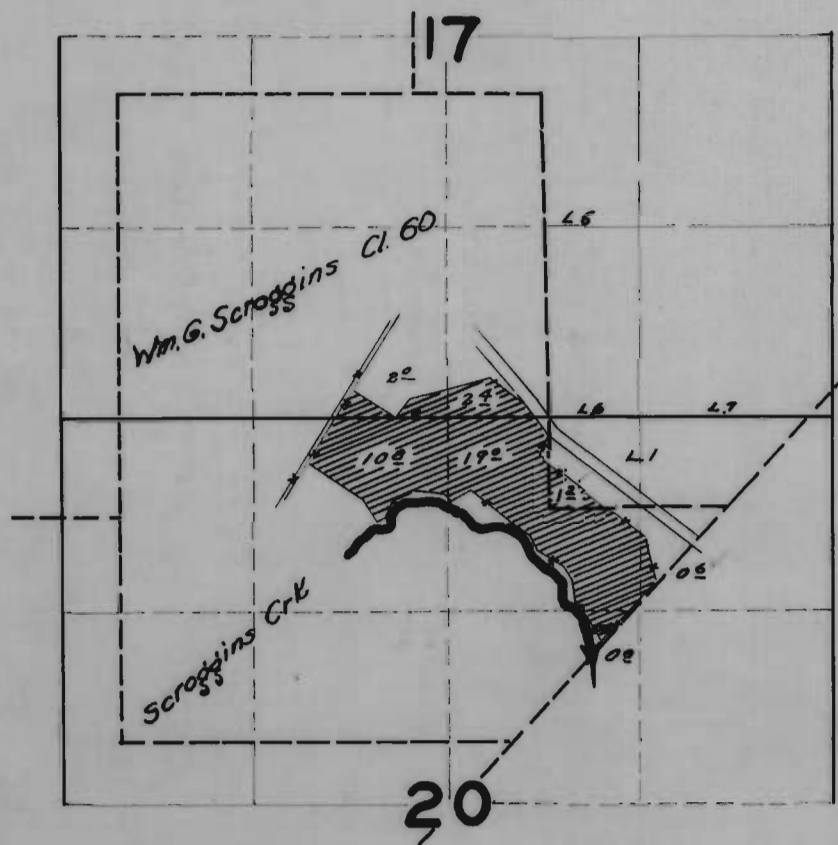

FINAL PROOF SURVEY

UNDER

Application No. 22894..... Permit No. 17998.....

IN NAME OF

MERLE SHEELER

Surveyed Apr. 11, 1952, by H. L. COFFMAN...