


T. 1 S. R. 4 W. W. M.

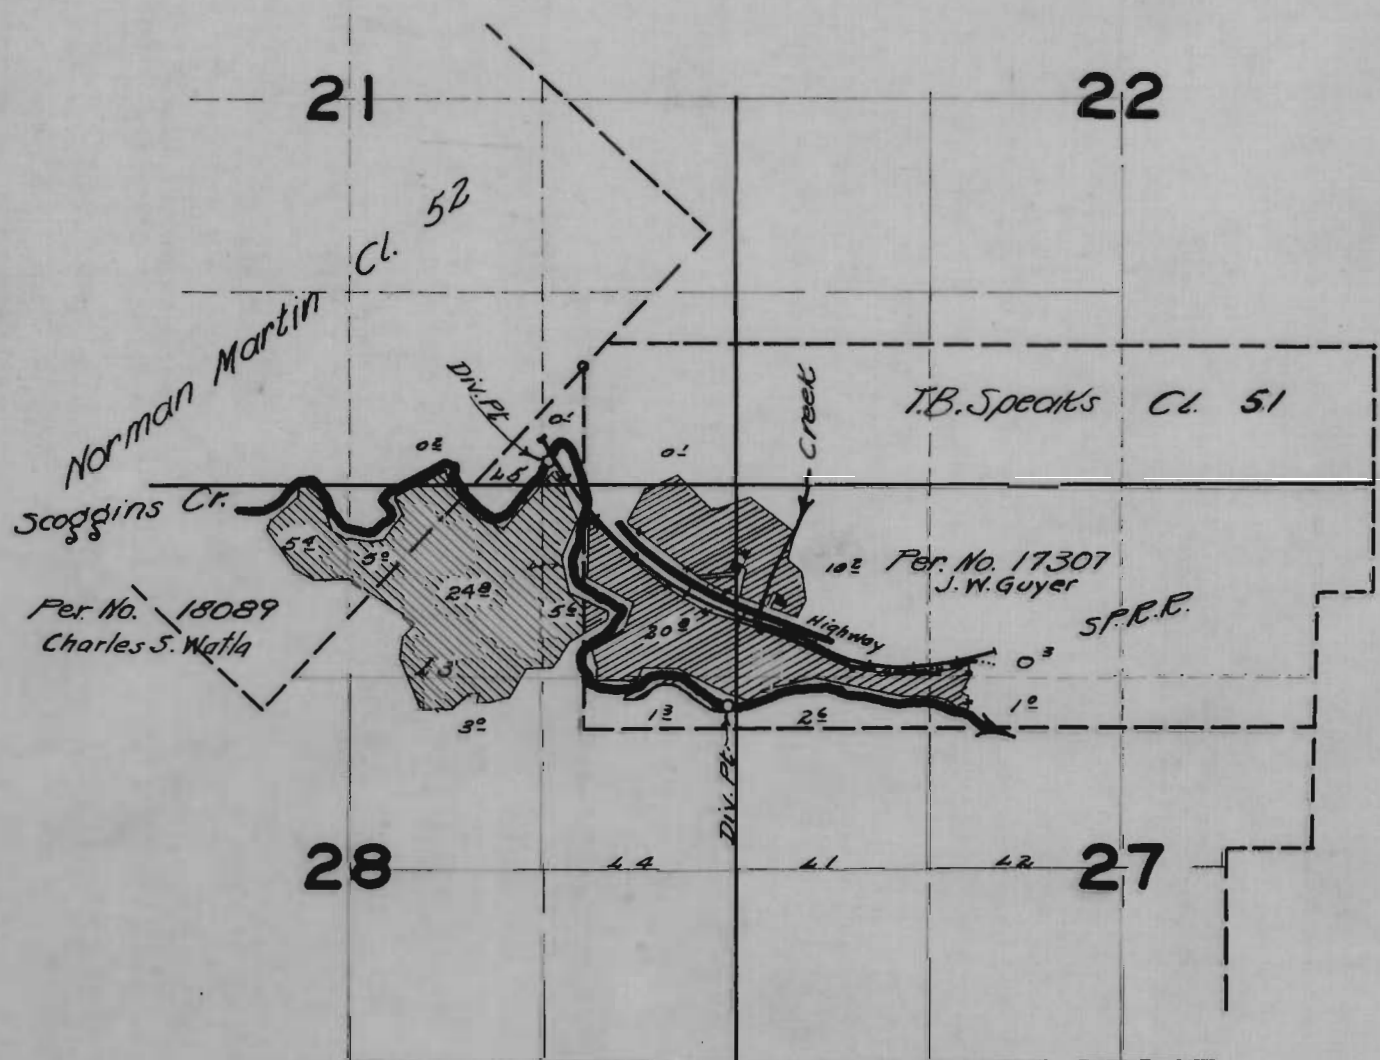

FINAL PROOF SURVEY

UNDER  
22954 18089  
Application No. 22027 Permit No. 17307  
IN NAME OF  
CHARLES S. WALTA  
J. W. GUYER

Surveyed Apr. 9, 1952, by H. L. Coffman