


# T.I.S. R.4W.W.M.

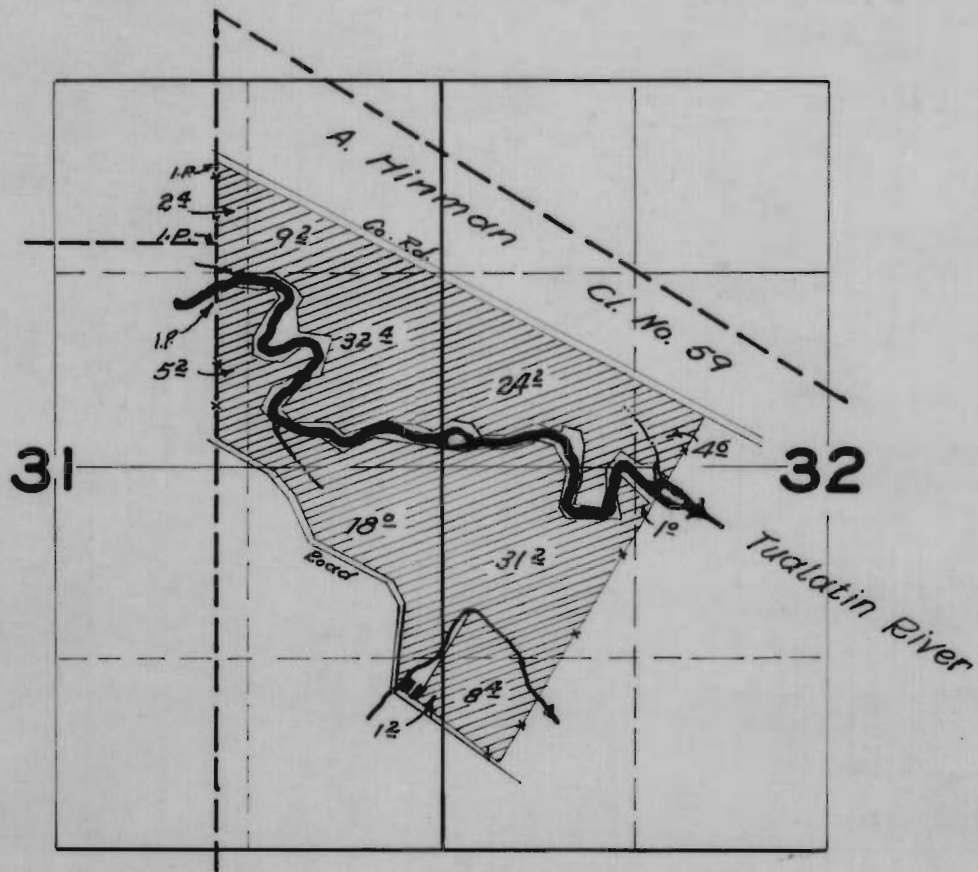

## FINAL PROOF SURVEY

UNDER

Application No. 23037.. Permit No. 18150 ..  
IN NAME OF

..... JOHN MULHOLLAND .....

Surveyed ARR. 7. 1952., by H.L. COFFMAN ..