


T. 1 S. R. 4 & 3 W. W. M

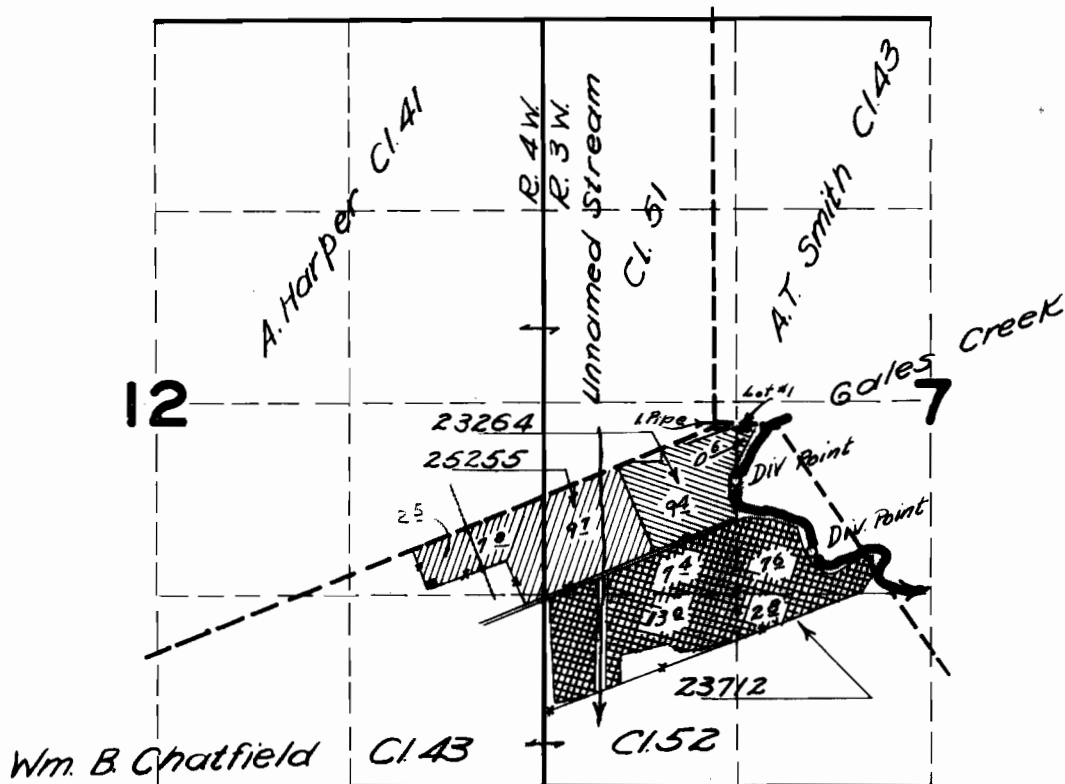

FINAL PROOF SURVEY

23264 & 18130 &
 25255 19840
 Application No. 23712 Permit No. 18725

IN NAME OF
 IVAN M. & EDITH R. AVENT
 MARTIN EDWARD GERDES

Surveyed May 21, 1952, by H. L. COFFMAN