


T. 1 S. R. 4 W. W. M.

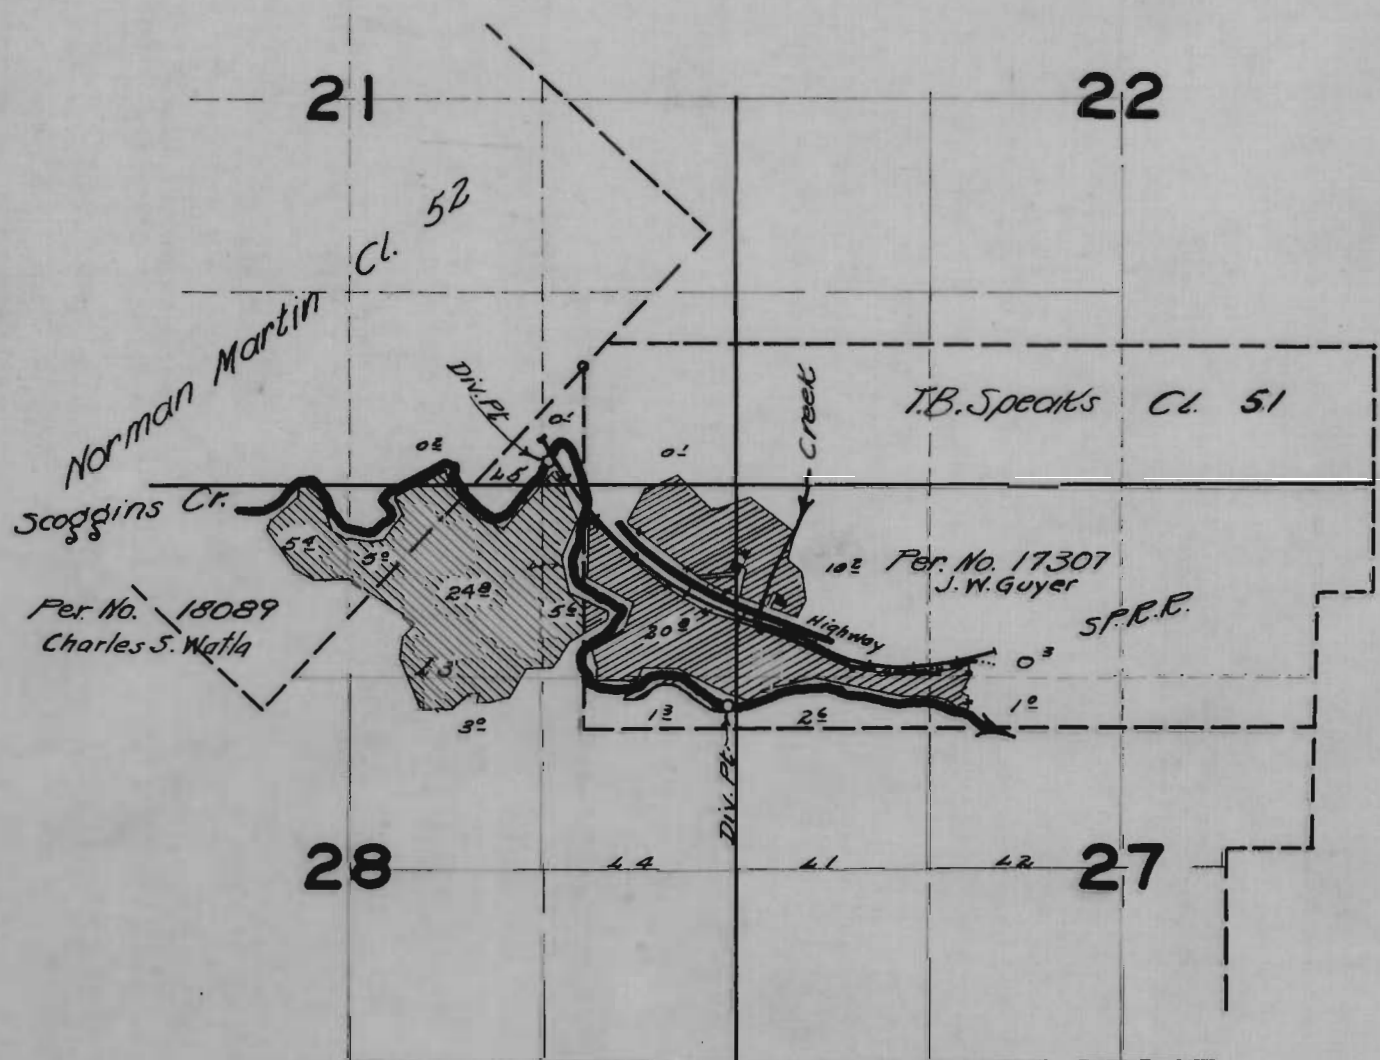

FINAL PROOF SURVEY

UNDER

22954

18089

Application No. 22027

Permit No. 17307

IN NAME OF  
CHARLES S. WALTA

J. W. GUYER

Surveyed Apr. 9, 1952, by H. L. Coffman