


T.3S.R.3E.W.M.

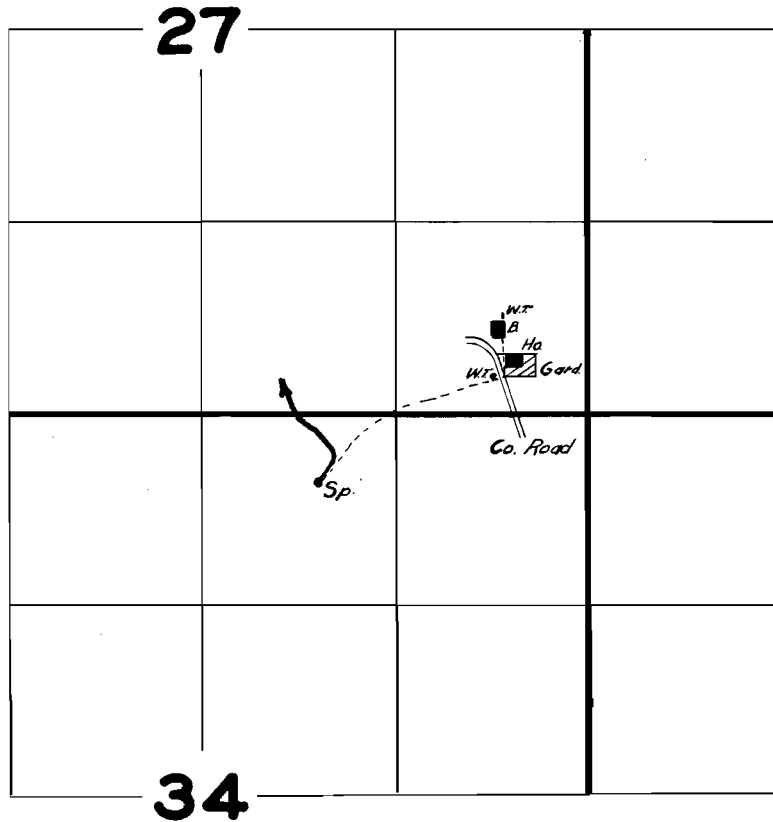

FINAL PROOF SURVEY

UNDER

Application No. 24233 Permit No. 19207

IN NAME OF

J. P. LAUSEN

Surveyed OCT. 14, 1952, by C. L. WHEELER