


T.18S.R.5W.W.M.

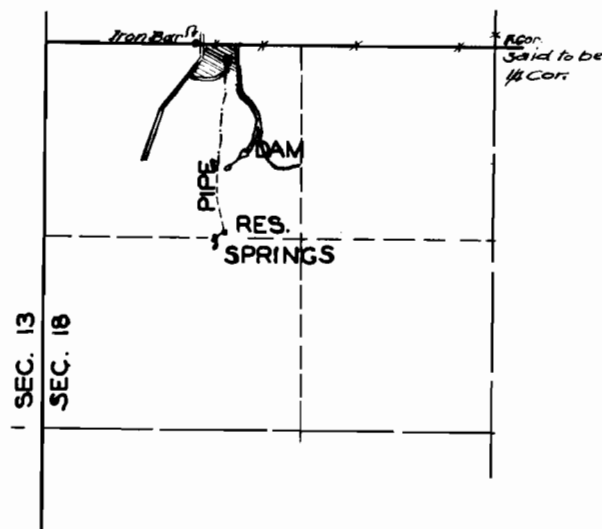

FINAL PROOF SURVEY

UNDER

Application No. 19285 Permit No. 14877
IN NAME OF

LEROY & EVA MELHORN

Surveyed MAY 18 1949, by H.L. COFFMAN