


T.4S.R.3E.W.M.

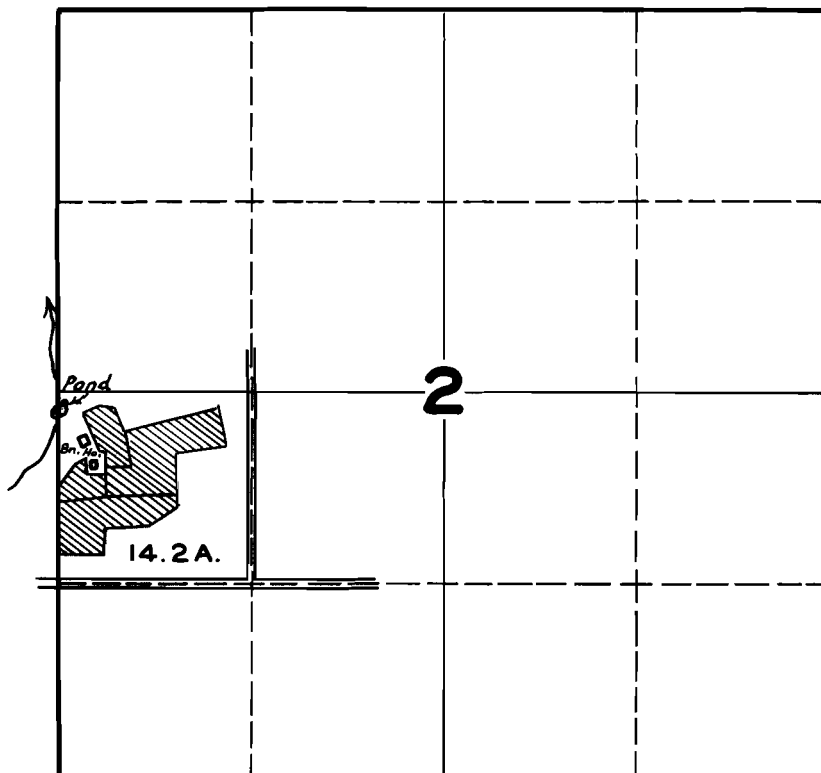

FINAL PROOF SURVEY

UNDER

Application No. **20268** **15799**
R-20269 Permit No. **R-791**

IN NAME OF

ROY M. OSTRANDER

Surveyed **AUG. 6** 1948, by **JAS. E. BUNNELL**