


T. I. S. R. 2 W. W. M.

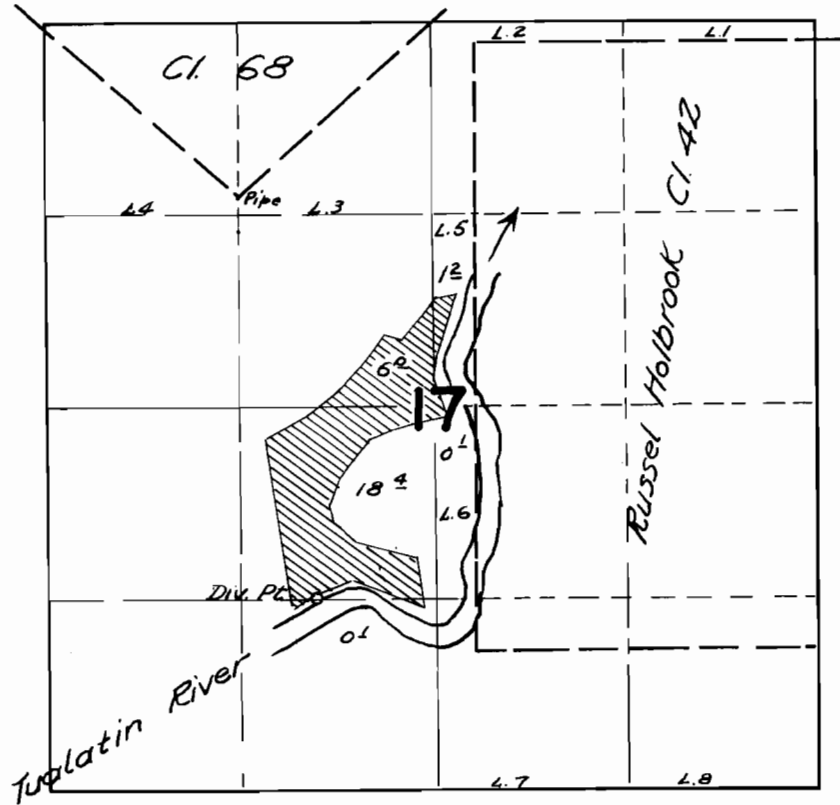

FINAL PROOF SURVEY

UNDER

Application No. 20828 ... Permit No. 16297...

IN NAME OF

HENRY J. VANDERHELEN

Surveyed ... BY 15, 1952, by H. E. COFFMAN