


T.7S.R. 2 W.W.M.

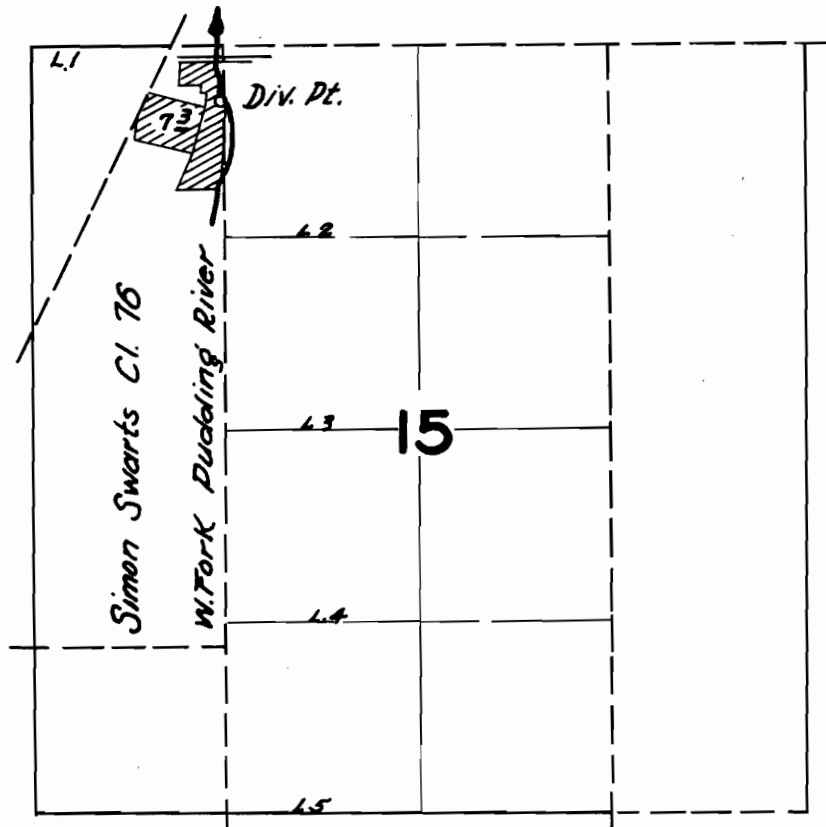

FINAL PROOF SURVEY

UNDER

Application No. 21116 Permit No. 16547

IN NAME OF

C. E. STOLLER

Surveyed Aug. 18 1952, by H. L. COFFMAN