


T.1N.R.42E.W.M.

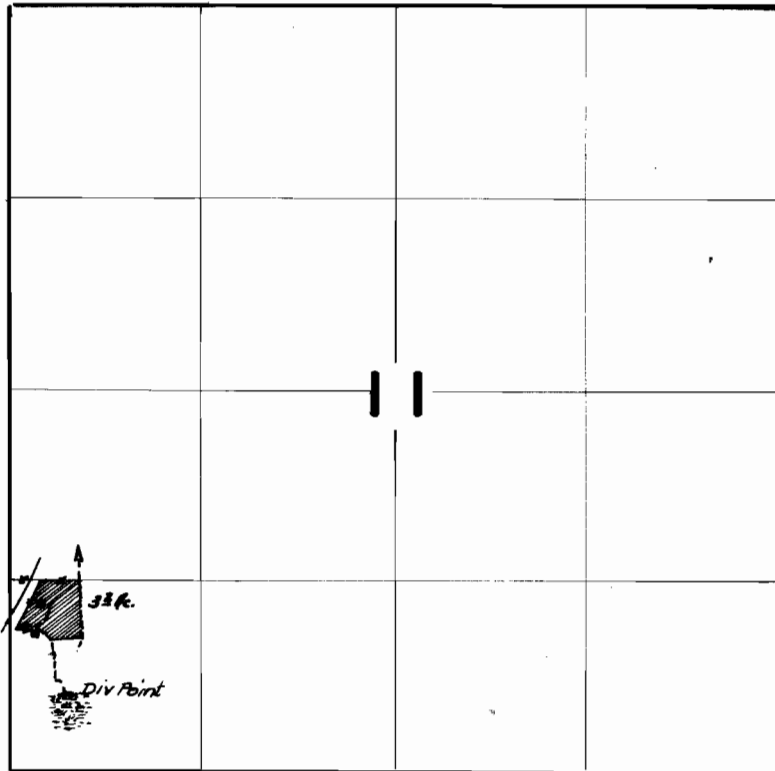

**FINAL PROOF SURVEY**

UNDER

Application No. 21875... Permit No. 17202..

IN NAME OF

.....RAY W. HENDERSON.....

Surveyed 10/28... 1951... by H.L. COFFMAN..