


T.7S.R.1W.W.M.

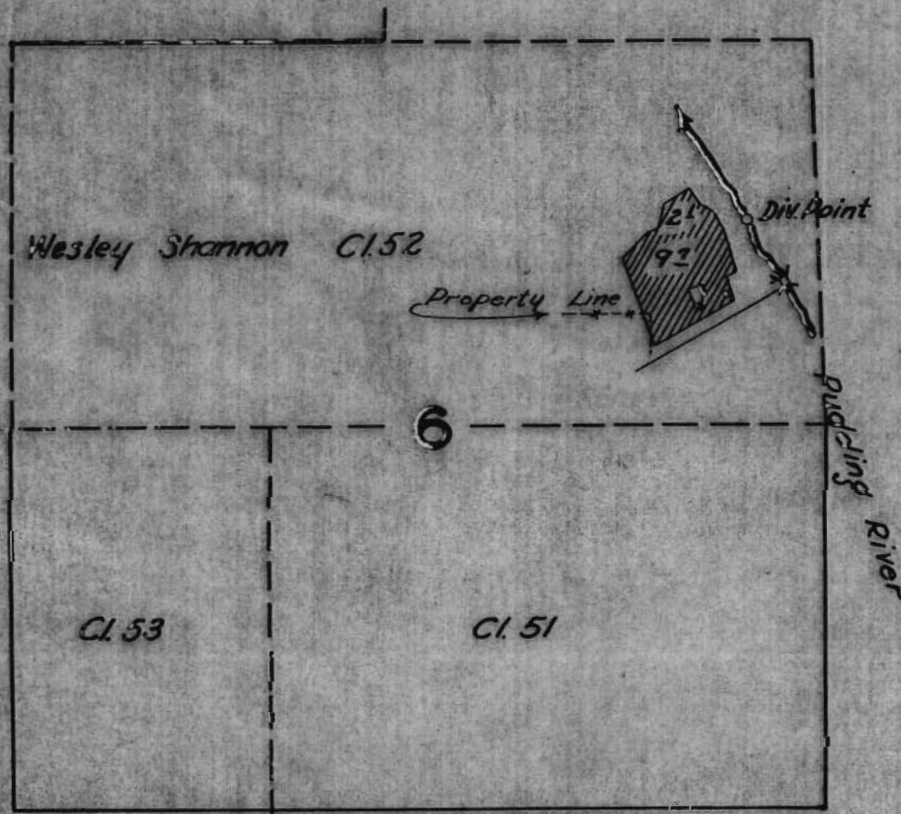

**FINAL PROOF SURVEY**

UNDER

Application No. 22000 Permit No. 17297

IN NAME OF

PERL L. BYE

Surveyed Aug. 18 19 52, by H. L. COFFMAN