


# T.5S.R.1W.W.M.

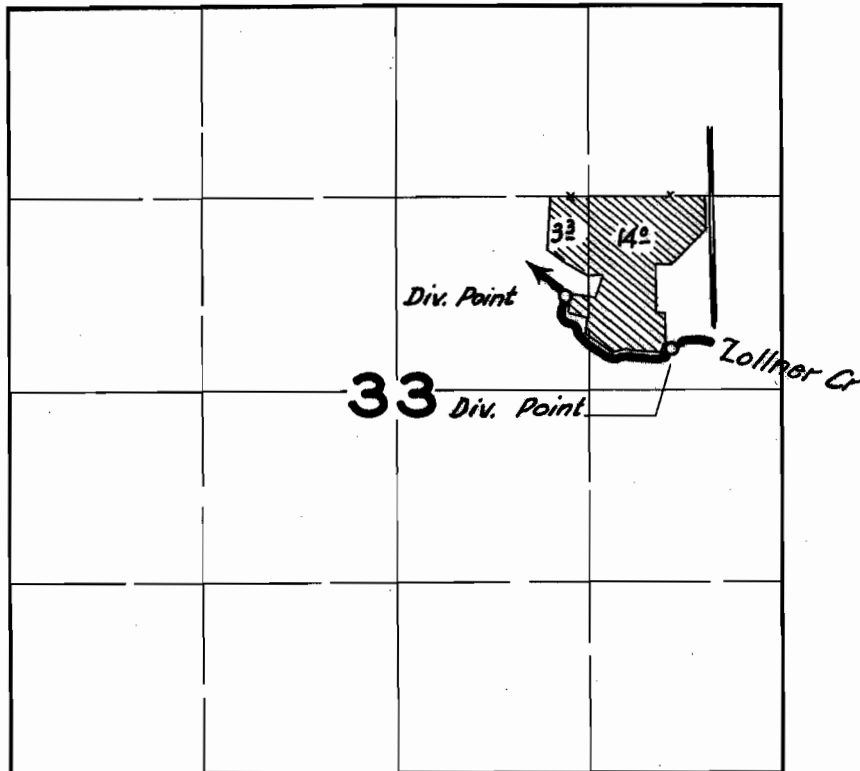

## FINAL PROOF SURVEY

UNDER

Application No. 22338 Permit No. 17613

IN NAME OF

C. B. LEEDER

Surveyed Aug. 26 1952, by H. L. COFFMAN