


T.2S.R.38E.W.M.

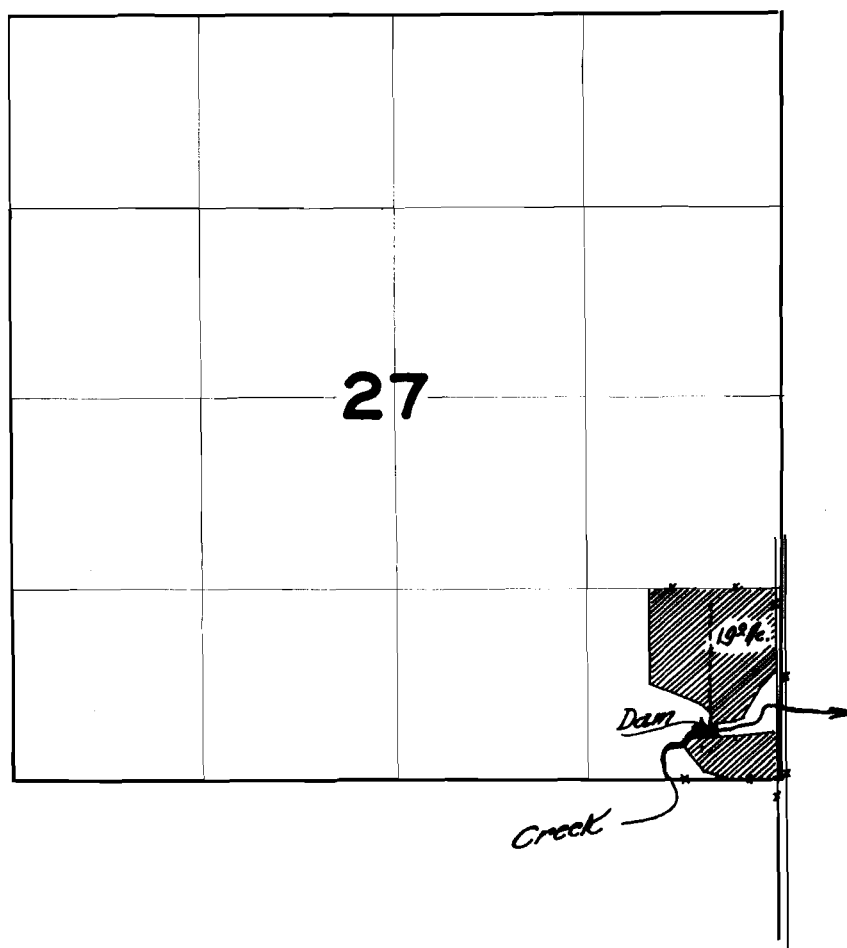

FINAL PROOF SURVEY

UNDER

Application No. 22398 Permit No. 17655
IN NAME OF

E.H. MCGREGOR

Surveyed 10/26 1951, by H.L. COFFMAN.