


# T.4S.R.IW.W.M.

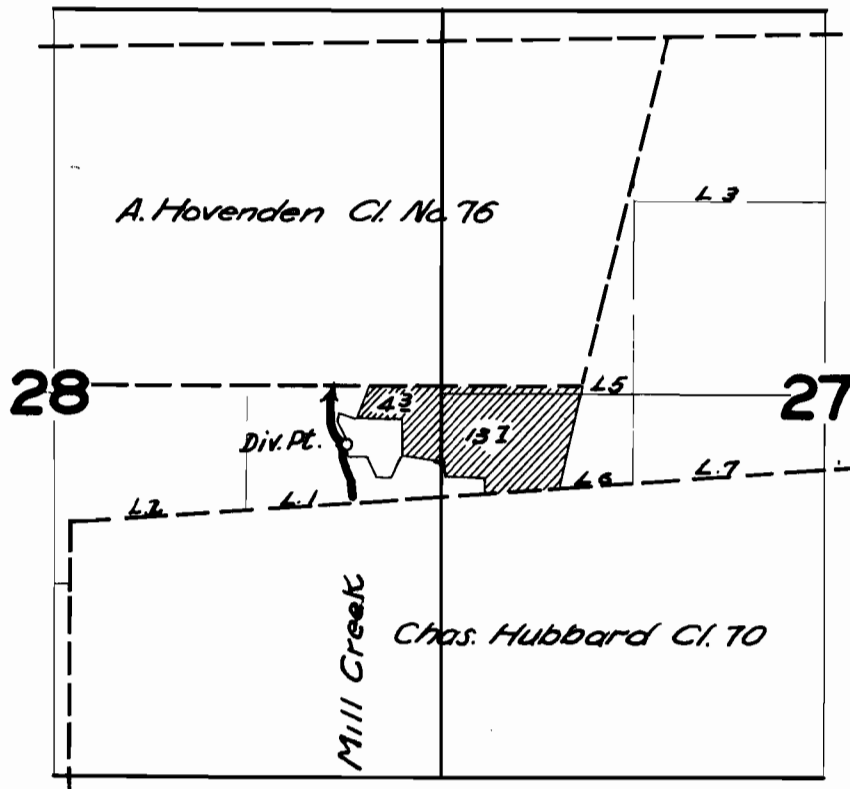

## FINAL PROOF SURVEY

UNDER

Application No. 22587 Permitt No. 17776

IN NAME OF

J. P. DOUBRAVA

Surveyed Aug. 28 19.52, by H. L. COFFMAN