


T.7S.R.1W.W.M.

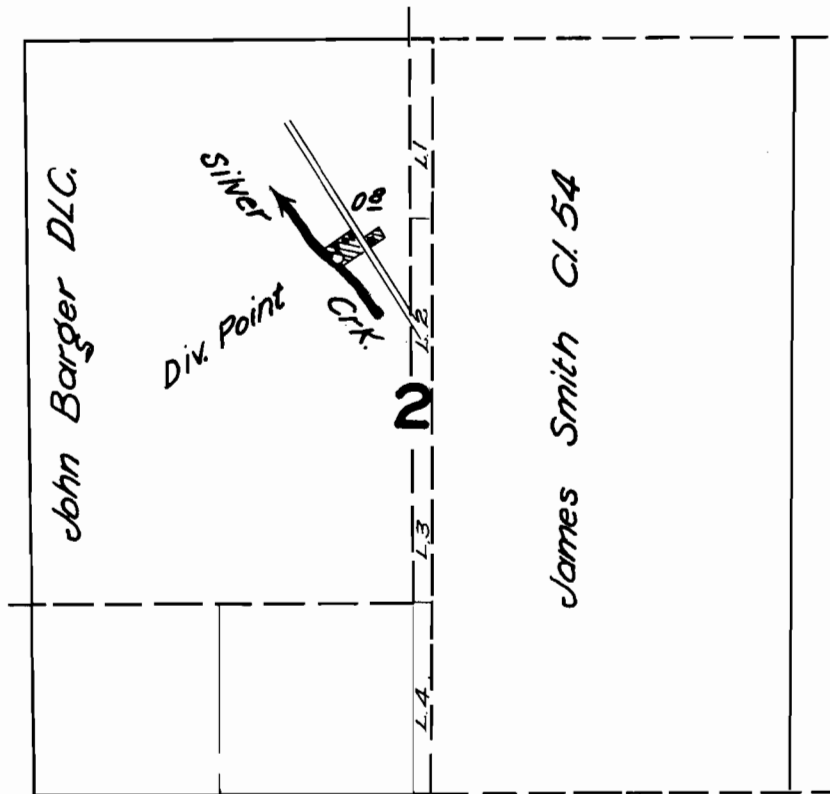

FINAL PROOF SURVEY
UNDER

Application No. 22608 Permit No. 17972

IN NAME OF

EDWARD J. COOVER

Surveyed Aug. 15 1952, by H. L. Coffman