


T. 8 S. R. 1 W. W. M.

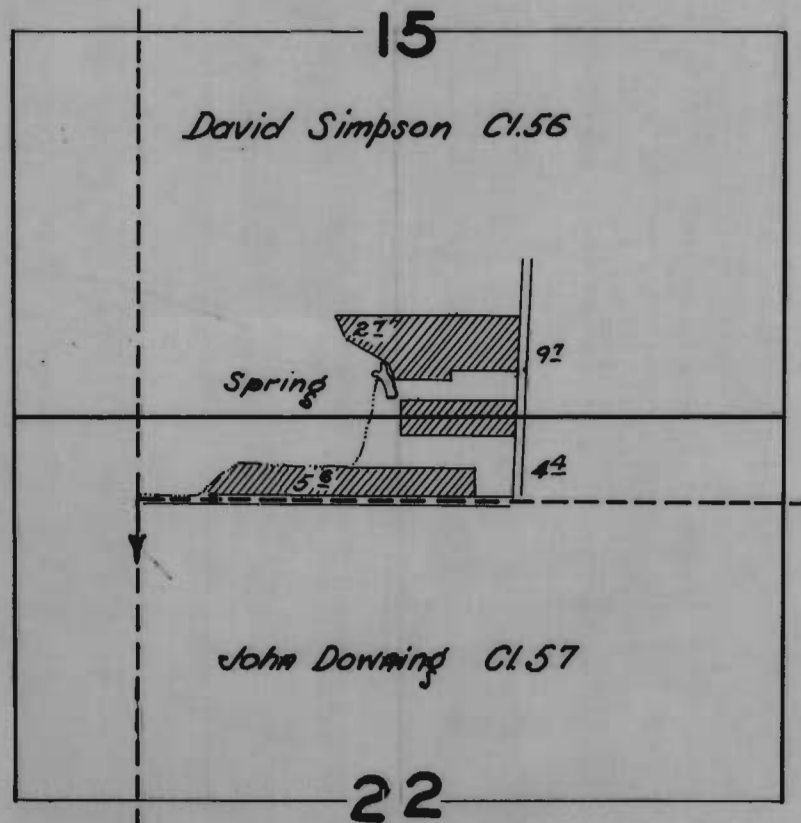

FINAL PROOF SURVEY

UNDER

Application No. 22924 Permit No. 18071

IN NAME OF

GERTRUDE M. PENDLETON, GERMAINE SHELTON, ZELPHA GROVER, WALTER L. SMITH, FERNANDO SMITH

Surveyed August 5 1952, by H. L. COFFMAN