


# T.7SR.2 W.W.M.

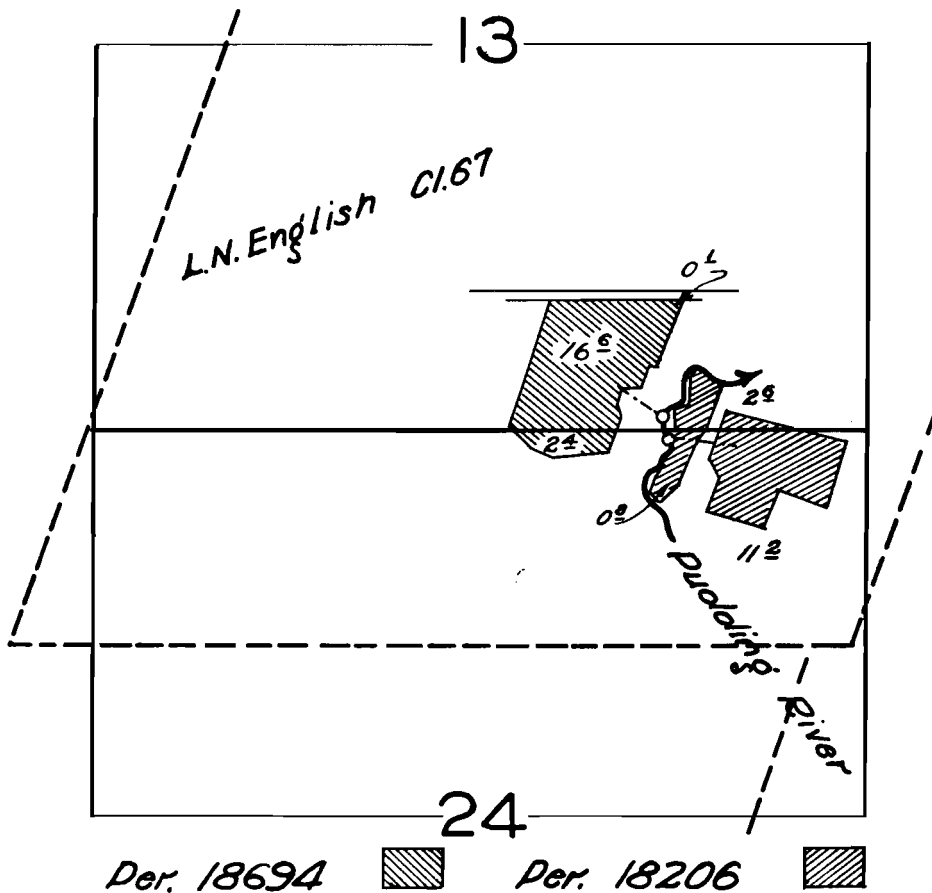

## FINAL PROOF SURVEY

UNDER

23070

18206


IN NAME OF

CORNELIUS LATTON & ALBERT SCHENKER

Surveyed August 3, 1952, by H. L. CRITMAN