


# T.8S.R.1W.W.M.

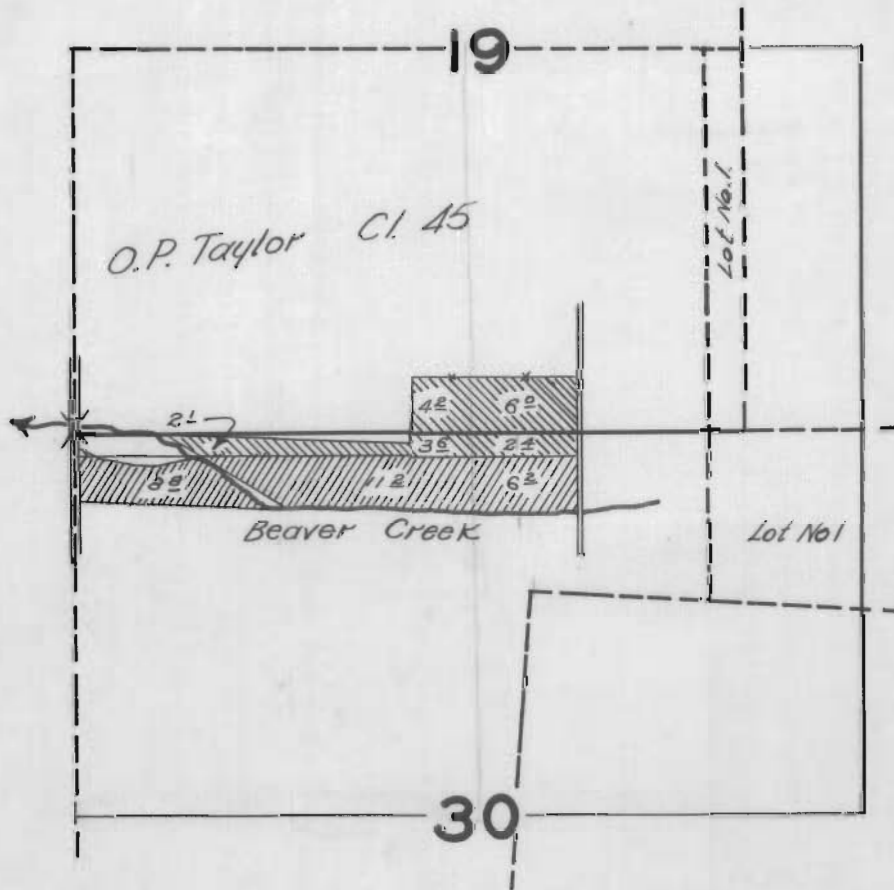

Permit 18069...  Permit 19094... 

## FINAL PROOF SURVEY

UNDER

Application No. 23823 Permit No. 19094  
22921 18069

IN NAME OF

KINDLE BROS.

Surveyed August 4 1952 by H. L. COFFMAN