
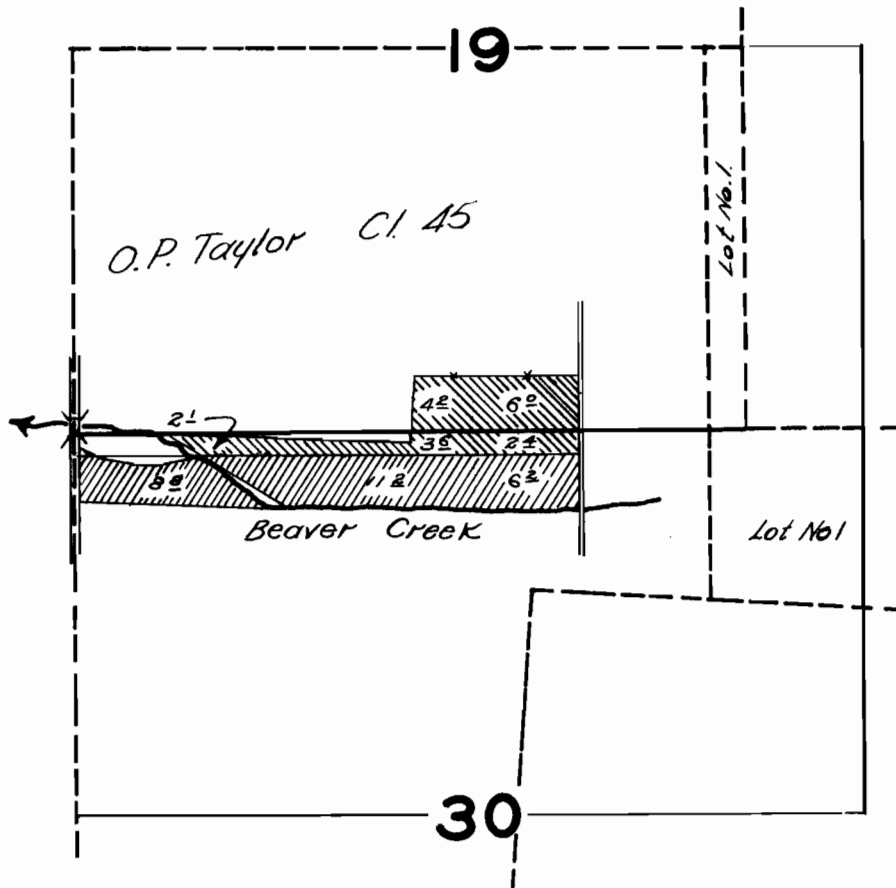



T.8S.R.1W.W.M.

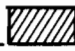

Permit 18069  Permit 19094 

FINAL PROOF SURVEY

UNDER

Application No. 23823 Permit No. 19094
22921 18069

IN NAME OF

W.M. LE BROS.

Surveyed August 4 1952, by E. D. WYMAN