


18256
20077

SEC. 5, T. 40 S. R. 4 E. W. M.

Application No. 23189

Permit No. 18256

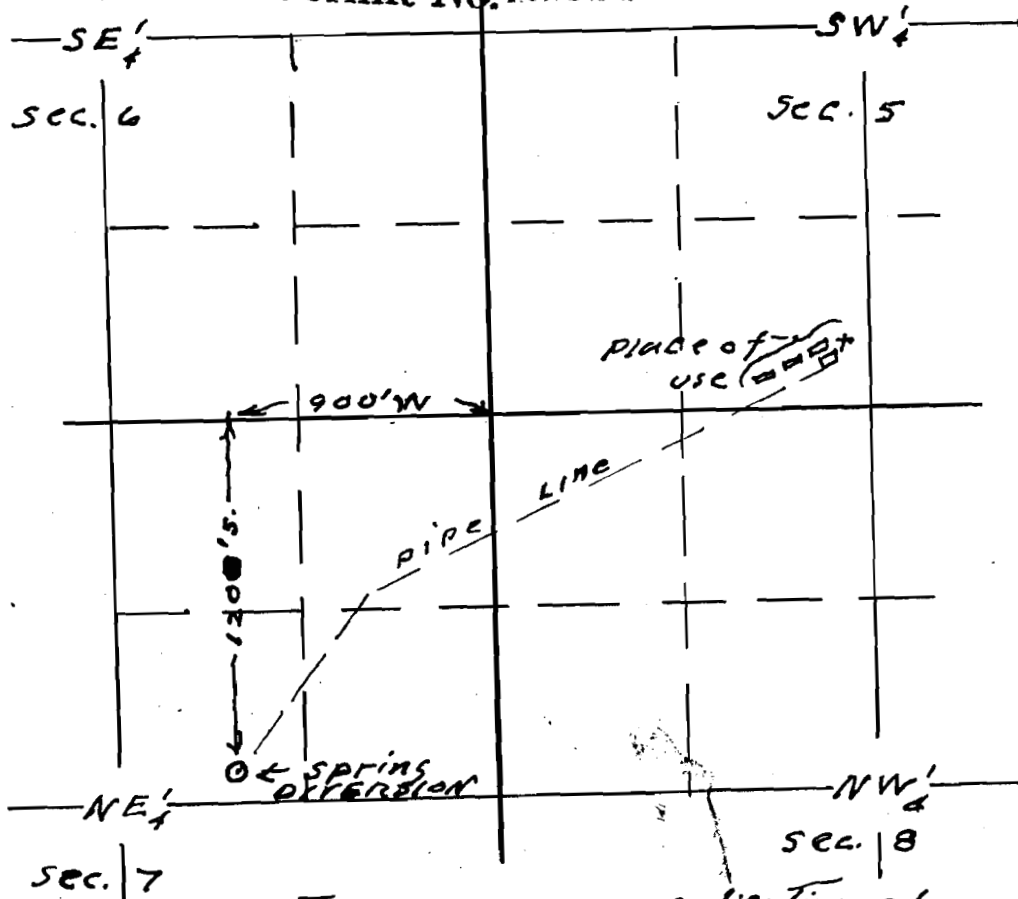

Map to accompany application of
Willard F. Mace for use of spring
for 3 cabins & service station
with 1/2 acre of garden

File office 5/15/1904