


T.3N.R.4W.W.M.

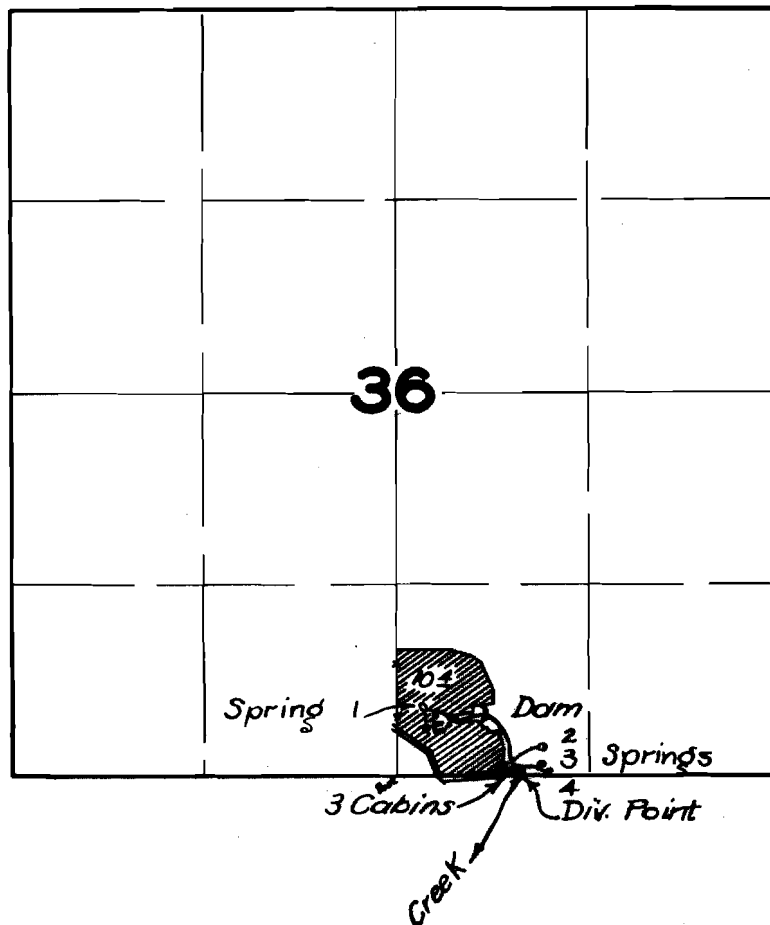

FINAL PROOF SURVEY
UNDER

Application No. 23298... Permit No. 18436...
IN NAME OF

JOHN LEITL

Surveyed 7 / 10 19 52, by H. L. COFFMAN