


# T.5S. R.1W.W.M.

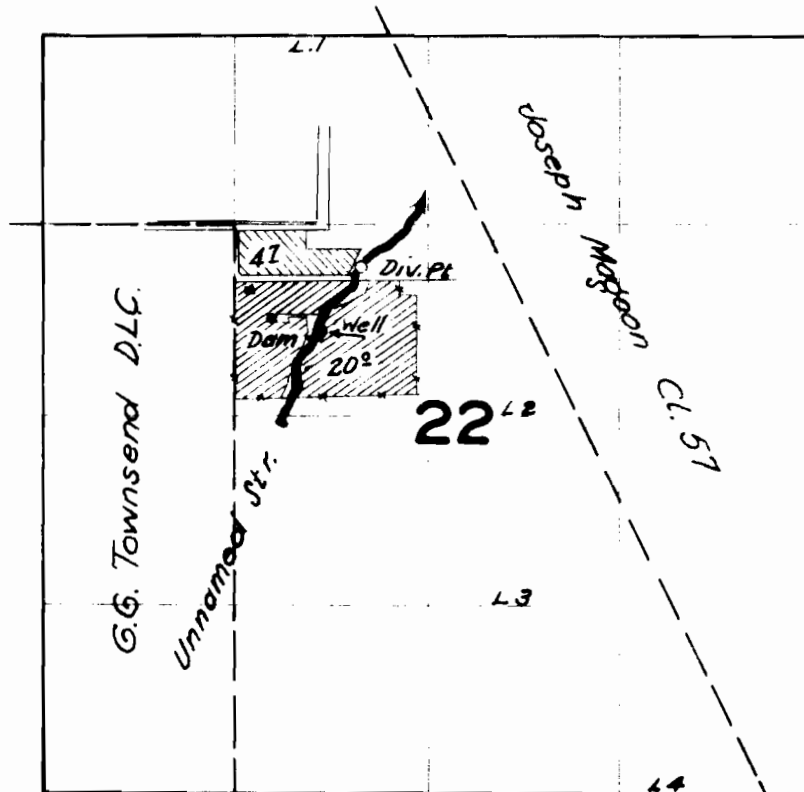

Permit 18562  Permit 18919 

## FINAL PROOF SURVEY

UNDER

Application No. 23331      Permit No. 18562  
                         23974      Permit No. 18919

IN NAME OF

CHARLES P. WIFFELS - JOHN H. BIGLER

Surveyed Aug. 26 1952, by H. L. COFFMAN